

Municipal Design Guidelines

2021

Part C: Drawing Standards



HALIFAX

Contents

- 1.0 PURPOSE AND AUTHORITY 1**
 - 1.1 GENERAL 1
- 2.0 DIGITAL STANDARDS..... 1**
 - 2.1 GENERAL 1
- 3.0 GEOGRAPHIC REFERENCE 1**
 - 3.1 GENERAL 1
 - 3.1.1 Horizontal Datum 1
 - 3.1.2 Vertical Datum 1
 - 3.1.3 Map Projection..... 2
 - 3.1.4 Units 2
 - 3.1.5 Unit Accuracy..... 2
 - 3.2 SURVEY DATA 2
- 4.0 DESIGN DRAWINGS..... 2**
 - 4.1 GENERAL 2
 - 4.2 PRESENTATION 3
 - 4.2.1 Units 3
 - 4.2.2 Scale 3
 - 4.2.3 Title block 3
 - 4.2.4 Standard notes 3
 - 4.2.5 Key plan..... 3
 - 4.2.6 Sheet size..... 3
 - 4.2.7 North arrow 3
 - 4.2.8 Plan orientation..... 3
 - 4.2.9 Plan details 4

| | | |
|------------|---|----------|
| 4.2.10 | Details..... | 4 |
| 4.3 | PLAN | 4 |
| 4.4 | PROFILE | 4 |
| 4.5 | SIGNING OF DRAWINGS | 5 |
| 4.6 | FORMAT | 5 |
| 5.0 | RECORD DRAWINGS..... | 5 |
| 5.1 | GENERAL | 5 |
| 5.2 | FORMAT | 5 |
| 5.2.1 | Hard Copy | 5 |
| 5.2.2 | Electronic format..... | 5 |
| 5.3 | SPATIAL DATA DELIVERY FORMAT | 5 |
| 5.4 | FEATURE CODES | 6 |
| 6.0 | SUBMISSION OF DIGITAL CAD FILES..... | 6 |
| 6.1 | GENERAL | 6 |
| 6.2 | DELIVERY MEDIA..... | 6 |
| 6.3 | ACCEPTABLE DELIVERY FORMAT..... | 6 |
| 6.4 | DRAWING CLEAN-UP | 6 |
| 6.5 | DOCUMENTATION | 6 |
| 7.0 | DIGITAL CAD DRAWING STRUCTURE..... | 7 |
| 7.1 | GENERAL | 7 |
| 7.2 | LAYERS | 7 |
| 7.3 | FCODES..... | 7 |
| 7.3.1 | Block Reference - Point Features | 7 |
| 7.3.2 | Linetype - Line Features | 8 |
| 7.4 | PROTOTYPE DRAWINGS | 8 |

| | | |
|-------------|--|-----------|
| 7.4.1 | Hrmtemplate.dwt..... | 9 |
| 7.4.2 | assemblies.dwg | 11 |
| 7.4.3 | hrmpp.dwt..... | 11 |
| 7.4.4 | hrmmapbook.dwt | 11 |
| 7.4.5 | hrmsubtemplate.dwt..... | 11 |
| 7.5 | AVAILABLE DATA..... | 11 |
| 7.6 | LETTERING AND DIMENSIONS..... | 12 |
| 7.7 | RULES FOR WRITING NUMBERS | 12 |
| 8.0 | AUTOCAD DATA ENTRY: FEATURE CREATION..... | 13 |
| 8.1 | GENERAL | 13 |
| 8.2 | FEATURE COLLECTION | 13 |
| 8.2.1 | Road..... | 13 |
| 8.2.2 | Sidewalk | 13 |
| 8.2.3 | Fences..... | 13 |
| 8.2.4 | Buildings | 13 |
| 8.2.5 | Structures | 13 |
| 8.2.6 | Trees, signs, poles..... | 14 |
| 9.0 | HARD COPY PLOTS..... | 14 |
| 9.1 | GENERAL | 14 |
| 9.2 | SCALES | 14 |
| 9.3 | PLOT STYLE..... | 15 |
| 10.0 | GENERAL CONDITIONS..... | 15 |
| 10.1 | STREET NAMES..... | 15 |
| 10.2 | INTERSECTION IDENTIFICATION | 15 |
| 10.3 | PERCENT (%) GRADE | 15 |

| | |
|--------------------------------------|-----------|
| 10.4 REVISIONS TO PLAN | 15 |
| 10.5 SIGNING OF PLANS | 16 |
| 11.0 LEGAL PLANS DETAILS..... | 16 |
| 12.0 APPENDICES..... | 16 |

1.0 PURPOSE AND AUTHORITY

1.1 GENERAL

- The purpose of this document is to standardize and identify requirements for the preparation and delivery of computer aided drafting drawings (CAD) being done by or for the Halifax Regional Municipality (HRM), and drawings requiring the approval of the HRM.
- These standards are issued under the authority of the HRM.
- These standards are mandatory for all drawings prepared for and submitted to HRM, including Subdivision drawings, Design Engineering drawings, Right-of-Way infrastructure drawings, any other engineering drawings and Legal drawings.
- These standards apply to hard copy and digital drawing preparations.
- These standards define the structure for digital drawing files for the purpose of compiling HRM's Infrastructure GIS database.
- This procedure is subject to change without notification and the onus is on the user to ensure that they use the latest revised edition.
- Any deviation from these standards is prohibited unless approved by HRM and must be submitted with documentation detailing the CAD drawing structure so as to facilitate the compilation of HRM's Infrastructure GIS database.

2.0 DIGITAL STANDARDS

2.1 GENERAL

- The Halifax Regional Municipality creates engineering drawings with AutoCAD Civil 3D.
- All design and record drawings created for submission to HRM shall be compatible with AutoCAD's DWG format.
- The digital standards described in this document are contained within HRMs PROTOTYPE drawings (DWT/DWG) and are available upon request.
- Details regarding the standards are outlined in the remainder of the document.
- Drawings prepared using other CAD packages are acceptable if and only if they meet the requirements defined in this procedure.

3.0 GEOGRAPHIC REFERENCE

3.1 GENERAL

Nova Scotia Coordinate Referencing System: all work shall be referenced using real world coordinates.

3.1.1 Horizontal Datum

All geographic referenced points shall be NAD83(CSRS) Epoch 2010.0, as defined by the control monuments in the Nova Scotia Coordinate Referencing System.

3.1.2 Vertical Datum

All geographic referenced points shall be Canadian Geodetic Vertical Datum 2013 (CGVD2013), as defined by the control monuments in the Nova Scotia Coordinate Referencing System.

3.1.3 Map Projection

All geographic referenced data shall be referred to zone 5 (Central Meridian 64° 30' West Longitude) or zone 4 (Central Meridian 61° 30' West Longitude) of the Nova Scotia 3° Modified Transverse Mercator Projection of the horizontal datum (MTM Zone 4 and Zone 5).

3.1.4 Units

All coordinates, measurements and dimensions shall be expressed in metric units.

3.1.5 Unit Accuracy

All coordinates, measurements and dimensions shall be expressed to a minimum of 3 decimal places.

3.2 SURVEY DATA

The surveyor shall:

- (a) Separate features by layer before the information is transferred to the CAD drawing to simplify the drawing structure as per Section 7.0 - Digital CAD Drawing Structure;
- (b) All features captured via survey shall be identified and coded according to HRM feature codes (FCODES) as defined in the HRM Survey field code library, and Appendix D;
- (c) The HRM survey field code library is available at <http://www.halifax.ca/designcon/design/munservices.html> or upon by request;
- (d) Original Survey shots shall be submitted digitally as per Section 6.0 - Submission of Digital CAD files.

4.0 DESIGN DRAWINGS

4.1 GENERAL

All design drawings, hard copy and digital, shall include (with each specification detailed further in the document):

- Plan
- Profile
- Details as required / project specification
- Overall plan
- Legend

- Scale
- Title block
- North arrow
- Key plan
- Survey control table
- Proposed centerline alignment table and layout

4.2 PRESENTATION

The presentation of the plan and profile components of the engineering design drawing shall be as follows:

4.2.1 Units

METRIC

4.2.2 Scale

1:500, 1:250, 1:200 or as directed by the HRM Engineer in charge or the engineer the CAD technician reports to.

4.2.3 Title block

The title block is to be located in the lower right-hand corner of the sheet as seen in figure DS 02 and is to include key plan, legend, notes, revisions, dates, scales, drawing number, approving signatures, drawing title and company name as seen in figures DS 04, DS 05 and DS 07.

4.2.4 Standard notes

Standard notes must be placed in appropriate sections of the title block as seen in figure DS 24.

4.2.5 Key plan

The key plan is to be placed in the area provided at the top of the title block for all drawings, which clearly shows the project location within the community.

4.2.6 Sheet size

Drawings comprising a set shall be of uniform size. A standard plan/profile drawing shall be sheet size A1, refer to figure DS 01 for details or as approved by HRM. A1 and A1+ sheet size with layouts are included in the HRMTEMPLATE.dwt.

4.2.7 North arrow

A north arrow shall be placed in the upper right-hand corner of the plan area. A NORTH arrow symbol shall be used for all plans as shown in Figure DS 10.

4.2.8 Plan orientation

Plans shall be drawn to be viewed from the bottom or right-hand side only with north arrow pointing upwards (between 9 and 3 o'clock), when possible. All Horizontal and Vertical chainages shall increase from left to right.

4.2.9 Plan details

See appropriate procedure for details on drafting various types of plans (i.e., survey plan, tentative plan, final plan, street design plan, etc.).

4.2.10 Details

To be included as required by or as directed by the Engineer.

4.3 PLAN

The engineering design plan shall include:

- (a) The existing and proposed location and horizontal alignment of:
 - (i) Curbed roads, sidewalks and driveways;
 - (ii) Traffic markings and infrastructure;
 - (iii) Sanitary and storm sewer systems and appurtenances;
 - (iv) Water system and appurtenances;
 - (v) Fencing, retaining walls, guide rails and other barrier infrastructure;
 - (vi) Utility systems both above and below ground, including underground power, telecommunication systems or gas lines etc.;
 - (vii) All other public services and their appurtenances;
 - (viii) Cross-section and details are to be scaled to fully illustrate the subject matter.
- (b) Street dimensioning and name;
- (c) Boundary lines of each lot, civic number and PID where available;
- (d) Chainage at 50m intervals along the centreline of the street and the chainage of all intersecting street centrelines;
- (e) Any control monuments and bench marks that are within the area of the plan;
- (f) Limits of the construction;
- (g) Survey control table as per figure DS 12;
- (h) Proposed centreline alignment table and layout as per figure DS 12.

4.4 PROFILE

Engineering design drawing profile shall include the existing and proposed location and vertical alignment of:

- (a) The proposed centreline street grade;
- (b) The finished grade;
- (c) The water system, including size, material, elevation/depth, fitting inverts;
- (d) The sanitary sewer and storm sewer systems, including manhole and catch basin lead inverts, material, size, elevation, depth of cover;
- (e) Any other underground services and appurtenances;
- (f) Profile grid - the profile section of a plan must be plotted on Halifax Regional Municipality standard grid. See figures DS 17 and DS 18 for line weights, placement of text, etc.;
- (g) Scale - 1:50.

4.5 SIGNING OF DRAWINGS

The engineering design drawing shall be stamped and signed by a Professional Engineer currently registered to practise in Nova Scotia.

4.6 FORMAT

The format of the design drawing shall be:

- Hard copy on 20 lbs paper;
- Electronic format as per Section 6.0 - Submission of Digital CAD files.

5.0 RECORD DRAWINGS

5.1 GENERAL

- The record drawing shall include all information on the “Design Drawing” as per Section 4 revised to reflect the “as recorded” information.
- Record Drawings are required upon completion of all engineering projects to reflect “as recorded” information. The parties responsible for the preparation of Record Drawings will be determined and agreed upon prior to the awarding of all contracts.

5.2 FORMAT

Record information submission shall include both of the following formats:

5.2.1 Hard Copy

All signed original plots shall be plotted on stable base (minimum) 3 mil film as per Section 9.0 - Hard Copy Plots;

5.2.2 Electronic format

As per Section 6.0 - Submission of Digital CAD Files, Section 7.0 - Digital CAD Drawing Structure and Section 8.0 Auto CAD Data Entry: Feature Creation.

5.3 SPATIAL DATA DELIVERY FORMAT

All RECORD data must be submitted in ASCII format as described in Section 6 - Submission of Digital CAD Files and within a CAD drawing, conforming to HRM’s Drawing Standards defined in this document. Specifically;

- (a) RECORD data must be placed on “RECORD SURVEY” layers as defined in the HRM Prototype Drawing, described in Section 7 - Digital CAD Drawing Structure;
- (b) Proposed data / future development data shall be removed from the digital record drawing submission;
- (c) RECORD submission shall include RECORD SURVEY data only.

5.4 FEATURE CODES

All RECORD features shall be identified and coded according to HRM feature codes (FCODES) both in the submitted digital CAD file and the submitted ASCII file as described in Section 6 - Submission of Digital CAD Files.

HRM FCODES are listed in Appendix C of this document.

6.0 SUBMISSION OF DIGITAL CAD FILES

6.1 GENERAL

The following guidelines must be followed for acceptable delivery of CAD files to Halifax Regional Municipality. Unless otherwise directed CAD files will not be required for legal drawings.

6.2 DELIVERY MEDIA

- (a) Compact disk (CD);
- (b) e-mail;
- (c) as otherwise approved by HRM.

6.3 ACCEPTABLE DELIVERY FORMAT

- (a) AutoCAD Drawing File Format (DWG);
- (b) Original Survey Field Shots: Data file or Text file in ASCII Format, where:

ASCII files shall contain fields in the following order: Point#, Northing, Easting, Elevation, FCODE (using HRM define FCODES);

- (c) If files are compressed, include appropriate software to explode or decompress files.

6.4 DRAWING CLEAN-UP

Prior to drawing submission ensure the following CAD functions have been performed on the digital drawing file (DWG):

- PURGE: removing unused layers and block references, removing PROPOSED or FUTURE Development layers;
- DRAWING CLEANUP: removing and correcting pseudo nodes, undershoots/overshoots, duplicate features and other topological errors;
- ETRANSMIT: automatically including associated XREFS, plot styles and font files with submission.

6.5 DOCUMENTATION

Documentation must accompany all CAD files. This documentation should contain the following information:

- (a) Contract number;

- (b) File name listing with descriptions;
- (c) Drawing name listing (if different from above);
- (d) Revision status and dates of CAD files;
- (e) CAD software name and version number;
- (f) ASCII file data structures, field sites (database information if applicable);
- (g) Data history (source, scale of original map if digitized, operations performed on data).

7.0 DIGITAL CAD DRAWING STRUCTURE

7.1 GENERAL

The digital CAD drawing structure ensures all drawing files (DWG) are produced with a consistent schema, regardless of producer, so that a single process can be used to migrate infrastructure features created via engineering efforts to a single GIS Infrastructure Database thereby eliminating human error and redundant efforts in the data creation process.

All CAD drawing files must contain a definite structure with respect to layering, linetypes, block references, lettering and dimensions. For specific details, refer to the appropriate template drawing details described in this section.

7.2 LAYERS

Layers have been defined to hold specific features. Each feature must be placed on the correct drawing layer. All layers are defined in the prototype drawings for the specific application:

Engineering Drawings: **HRMTEMPLATE.DWT**

Subdivision Engineering Drawings: **HRMSUBTEMPLATE.DWT**

Legal Survey Drawings: **LEGAL.DWG**

A list of layers (layer name, description, and linetype) is contained in Appendix A for Engineering Drawings and Subdivision Engineering Drawings as they follow the same layer structure as described in this section. See Appendix B for Legal Drawings.

7.3 FCODES

All features identified in the CAD file must be coded according to HRM feature codes (FCODES). FCODES are included in all HRM template drawings and listed in Appendix C.

7.3.1 Block Reference - Point Features

For point features this is accomplished through block references. Point features such as manholes, trees, poles, etc. must be symbolized using HRM block

references thereby assigning the correct HRM FCODE. Block references are included in all HRM template drawings.

All RECORD SURVEY symbolized point features are to be placed on layer HE-SYMBOLS-ALL

Ex. a Utility Pole is identified as UTPO therefore

Layer = HE-SYMBOLS-ALL

Block Reference = UTPO

All Blocks and Symbols listed in this document are contained in the prototype drawings.

Refer to figures DS 10 and DS 11 for commonly used symbols. For the remainder see HRMTEMPLATE.dwt and LEGAL.dwg or refer to Appendix C for the full block reference library.

All symbols used shall be denoted in the legend.

7.3.2 Linetype - Line Features

For linear features this is accomplished through linetypes. Linear features such as pipes, sidewalk, curb etc. must be symbolized using HRM linetypes thereby assigning the correct HRM FCODE and placed on the appropriate layer. Linetypes are included in all HRM template drawings.

Ex. a Curbed Road is identified as a RRCB therefore,

LAYER = HE-ROAD

LINETYPE = RRCB

See figures DS 14, DS 15 (for plan), and figures DS 17, DS 18 (for profile) for line weights, placement of text. A partial listing of lines (layer, linetype, description) is contained figure DS 25 of this procedure or refer to Appendix C.

For a complete list print "hrmlinesltscale1.lin".

7.4 PROTOTYPE DRAWINGS

HRM's Design staff have developed the following template drawings to facilitate the production of engineering drawings relating to HRM infrastructure.

They include:

- (a) hrmtemplate.dwt
- (b) assemblies.dwg
- (c) hrmp.dwt

- (d) hrmmmapbook.dwt
- (e) HRMSUBTEMPLATE.dwt

7.4.1 [Hrmtemplate.dwt](#)

This template drawing contains HRM's drawing standards for typical Design & Record Drawings.

7.4.1.1 Layer Structure

- (a) "HE-" layers represent Horizontal Existing (RECORD SURVEY) and hold various line features. See 7.4.1.7 for a complete list of RECORD LAYERS;
- (b) HE-SYMBOLS-All (RECORD SURVEY) - containing all symbolized points
- (c) "HP-" layers represent Horizontal Proposed features (point and line). See 7.4.1.8 for a complete list of PROPOSED LAYERS;
- (d) "...from HRM GIS" indicates data extracted from HRM's Infrastructure GIS database (point or line);
- (e) "VE-" layers represent Vertical Existing profile features (point and line);
- (f) "VP-" layers represent Vertical Proposed profile features (point and line)
- (g) "K-" layers represent Key Plan features;
- (h) Where a layer does not exist for a particular feature and a new layer must be added, it must follow HRM's standardized layer naming convention where RECORD SURVEY layers begin with "HE" and PROPOSED layers begin with "HP" and include an appropriate description in the layers' description field.

7.4.1.2 Block References - defined by HRM Feature Codes (FCODE);

7.4.1.3 Linetypes - defined by HRM FCODES and listed in "hrmlinesltscale1.lin";

7.4.1.4 Standard drawing sheet sizes;

7.4.1.5 Civil 3D Styles - defined within the template to control the display and design characteristics of drawing objects. Any style defined by HRM is named as such. i.e. Point Label - HRM NO DISPLAY turns off the label display for POINT objects.

These styles are applicable to Civil 3D users only;

7.4.1.6 Description Keys - Defined for importing LandXML points by matching the raw Survey description key (FCODE) to the properties specified in that description key, applying the template properties to the point when it is created. The description keys show the code and sets the point style, the point label style, the format, and the layer properties.

Description Keys are applicable to Civil 3D users only;

7.4.1.7 Record Layers are as follows, all begin with “HE”:

| Layer Name | Description |
|-------------------|---|
| HE-BREAKLINES | RECORD SURVEY: Breaklines for TIN / Back of Curb / Centerline |
| HE-BUILDING | RECORD SURVEY: Building Line |
| HE-COMBINED | RECORD SURVEY: Combined Sewer Pipe |
| HE-CONTOUR | RECORD SURVEY: Contour Line |
| HE-DRIVEWAY | RECORD SURVEY: Driveway-parking-walkway Line |
| HE-FENCE | RECORD SURVEY: Fence Line |
| HE-GAS | RECORD SURVEY: Natural Gas Pipe Line |
| HE-HYDRO | RECORD SURVEY: Ditch-Lake-Stream Coast Line |
| HE-LABEL-ALL | RECORD SURVEY: All Labels |
| HE-OTHER | RECORD SURVEY: Miscellaneous Line |
| HE-PARCEL | RECORD SURVEY: Parcel Line |
| HE-POINTS-ALL | RECORD SURVEY: All Points |
| HE-ROAD | RECORD SURVEY: Road Line |
| HE-SAMPLE | RECORD SURVEY: Section Line of Plan |
| HE-SANITARY | RECORD SURVEY: Sanitary Sewer Pipe |
| HE-SIDEWALK | RECORD SURVEY: Sidewalk Line |
| HE-SLOPES | RECORD SURVEY: Slope Line |
| HE-STORM | RECORD SURVEY: Storm Sewer Pipe |
| HE-STREETLINE | RECORD SURVEY: Edge of Right-of-Way |
| HE-STRUCTURE | RECORD SURVEY: Structure Line |
| HE-SURFACE | RECORD SURVEY: Surface for TIN Line |
| HE-SYMBOLS- | RECORD SURVEY: All Symbolized Points |
| HE-TRAFFIC | RECORD SURVEY: Traffic Line |
| HE-TREE LINE | RECORD SURVEY: Tree Line |
| HE-UTILITY | RECORD SURVEY: Utility Line |
| HE-WATER | RECORD SURVEY: Water Pipe |

7.4.1.8 Proposed data must be placed on “PROPOSED” layers as defined below for Design Drawings and is applicable to Design Drawings only and not for Record Drawings.

Proposed Layers are as follows, all begin with “HP”.

| Layer Name | Description |
|-------------------|-------------------------------|
| HP-ASSEMBLY | PROPOSED: Assembly Template |
| HP-COMBINED | PROPOSED: Combined Sewer Pipe |

| | |
|------------------|-------------------------------|
| HP-CORRIDOR | PROPOSED: Corridor |
| HP-MARKING | PROPOSED: Pavement Markings |
| HP-LINK | PROPOSED: Assembly Link |
| HP-CORRIDOR-FLII | PROPOSED: Corridor |
| HP-ROAD | PROPOSED: Road Line |
| HP-SANITARY | PROPOSED: Sanitary Sewer Pipe |
| HP-SIDEWALK | PROPOSED: Sidewalk Line |
| HP-STORM | PROPOSED: Storm Sewer Pipe |
| HP-TABLE | PROPOSED: Alignment Table |

7.4.2 [assemblies.dwg](#)

For those using Civil 3D's corridor modelling functionality, this template combines horizontal and vertical constraints to generate a proposed roadway cross-section for a typical HRM 9m road with 2% crown. The template accounts for elements along the right-of-way that affect a road design. It has the ability to show changes in road width (following an alignment) and changes to the road crown.

7.4.3 [hrmpp.dwt](#)

For those using Civil 3D's Plan-Production Tools, this template contains the content to build a plot according to HRM's hard copy plot standard for 1:500 scale drawings. It contains HRM standard notes, title block, logo, legend, etc. It rotates views and the north arrow; it creates match lines; it generates HRM's standard profile.

7.4.4 [hrmmapbook.dwt](#)

This template is set-up to plot cross-sections for "working" drawings using mapbookcreate.

7.4.5 [hrmsubtemplate.dwt](#)

This template is set-up for Developers creating subdivision drawings in HRM and is the exact same as HRMTEMPLATE.dwt described in 7.4.1. in terms of layer structure, block reference library, linetype library, C3D styles, description keys, plot style and uses accompanying templates from sections 7.4.2, 7.4.3, 7.4.4. It differs in TITLEBLOCK layout only.

7.5 AVAILABLE DATA

The following data is available for the preparation of engineering drawings:

- (a) GIS Extracts - available if required by consultants preparing drawings initiated by the Halifax Regional Municipality and is released through a data license agreement, to be signed by the Consultant and a Halifax Regional Municipality representative. For a GIS data extraction, contact GEOINFO@halifax.ca
- (b) Survey Field Code Library is available at <http://www.halifax.ca/designcon/design/munservices.html> or upon request.

7.6 LETTERING AND DIMENSIONS

All lettering and dimensions must follow Halifax Regional Municipality standards defined in this document, refer to the standard drawings in Appendix D.

7.7 RULES FOR WRITING NUMBERS

- (a) Both the point and comma are widely used as the decimal marker. Only one type of marker shall be used in the one text. The decimal marker shall be positioned in line with the base of the associated numerals.
- (b) When the triad separator is required to facilitate the reading of long numbers, the separator shall be a space unless there is a compelling reason for it to be otherwise but in no case shall a point or comma be used. A space is not necessary with a four-digit group except when required for consistency, e.g. when it is in a column with other numbers having five or more digits.

Examples:

32 453.246 072 5

1245 (1 245 optional)

3.1416 (3.141 6 optional) but 3.141 59

This clause need not apply to monetary values.

- (c) If a numerical value less than one is written in decimal form, a zero shall precede the decimal.
- (d) Acceptable formats when showing Length, Area and Volume:

metres: **128.5** or **128.5 m** (in notes and on details)

millimetres: **1285** or **1285 mm** (in notes and on details)

square metres: **1285 m²**

cubic metres: **1285 m³**

8.0 AUTOCAD DATA ENTRY: FEATURE CREATION

8.1 GENERAL

The following guidelines are recommended for data entry using AutoCAD.

- (a) The PLINE command should be used instead of the LINE command for linear and polygon shaped features. PLINE will create a node/vertex combination which is important for developing topology within a GIS. SPLINE command shall never be used.
- (b) If data is obtained through digitizing, document the scale of the original source map.
- (c) All polygon features must be closed by using OSNAP tools (Near, Int, End, etc.).
- (d) Do not double-digitize boundary lines which separate adjacent polygons. Adjacent polygons (within a thematic layer) should share a common boundary.
- (e) All feature outlines will be captured so that the feature lies to the right of the line (right hand rule).
- (f) All single line features which possesses a direction of flow will be captured in the direction of flow (e.g. Sewer Pipe).

8.2 FEATURE COLLECTION

8.2.1 Road

- For curbed roadways locate face of curb at the gutter (RRCB) elevation to be taken at the top of the curb. Curves PC's plus enough shots in between to properly show curb location. Beginning and end of driveway cuts and pedestrian ramps.
- Medians and traffic islands will be collected in the same manner.

8.2.2 Sidewalk

Front and back edge of sidewalk (RRSW), all walkways (RRWK) and driveways (RRDR) where they intersect the curb and sidewalk.

8.2.3 Fences

Fences (STFE), guiderails (STGR), retaining Walls (STRW) and walls (STWL) - beginning, end and at any point where a change in direction occurs at ground level.

8.2.4 Buildings

Locate the actual corner of the siding of corner boards with sufficient points to create a building polygon (BLDG).

8.2.5 Structures

- For large concrete bases or platforms, the corners of that structure should be located, but if the base is 0.3 metres square or less, then locate the centre of the feature.

- Super mailboxes - locate as point features (midpoint of base nearest the curb).
- Bus shelters with no base pad instead they are located on sidewalks (midpoint of feature nearest the curb).

8.2.6 Trees, signs, poles

Locate centre of feature on ground nearest the curb.

9.0 HARD COPY PLOTS

9.1 GENERAL

The following guidelines must be followed when producing hard copy plots for the HRM.

- Plotting Media: All plots shall be plotted on stable base (minimum) 3 mil film.
- Size of plotting media: Sheet A1 and A1+ sizes can be found in the prototype drawings. See figure DS 01 for details.

9.2 SCALES

Plan scales for other drawings shall be as follows:

(a) Survey plan shall be:

- (i) 1:1000
- (ii) 1:500
- (iii) 1:250
- (iv) 1:200 (where warranted for legibility reasons)
- (v) as directed by HRM.

(b) Drainage plan shall be:

- (i) 1:500
- (ii) 1:1000
- (iii) as approved by the Engineer in charge.

(c) Key plan shall be not less than 1:20,000 or greater than 1:2,500.

(d) Expropriation plan shall be:

- (i) 1:500; or
- (ii) 1:200; or

- (iii) as approved by the HRM.
- (e) Detail plan shall be to a scale that will fully illustrate the subject matter.
- (f) Other plans - as directed by the HRM Engineer in charge.

9.3 PLOT STYLE

HRM's plot style must be followed in order to produce standard plots. All entities must be plotted with the correct line thickness as described in the standard drawings included as appendices to this section. See figures DS 14, DS 15 (plan), and DS 17, DS 18 (profile) for line weights, placement of text, etc.

HRM uses the named plot style HRMplotstyle.stb which is found in template drawing.

The named plot styles refer to traditional pen widths for lines when plotted. For example, the plot style "width 0.15" is a thin faded line used for "HE" record layers while the plot style "width 0.53" is a bold line to highlight and make construction features prominent so is used for "HP" proposed layers for construction drawings to show proposed features.

10.0 GENERAL CONDITIONS

10.1 STREET NAMES

All streets shall be identified with their proper names and printed outside of the street right-of-way for engineering drawings and inside the street right-of-way for all survey drawings.

10.2 INTERSECTION IDENTIFICATION

At intersecting streets or where the continuation of the streets is on other plans, the following shall be shown on the plan:

For Continuation See Plan No. 00000000

10.3 PERCENT (%) GRADE

Percent (%) grades (slopes) shall be shown for all appropriate services to two decimal places.

10.4 REVISIONS TO PLAN

If plans are revised, amended or altered, the date and the revisers initials shall be noted in the revision area of the Title Block on both the CAD drawing and on the hard copy. The revised hard copy must be updated with the appropriate approval signature. If two plans are retained with the same drawing number (original and revised), then a note must be placed on the original indicating that another plan exists with the same number. However, only one CAD file will be retained (the revised drawing).

10.5 SIGNING OF PLANS

Boundary Plans used in land conveyance, expropriation, subdivision, etc., shall be stamped and/or certified by a Nova Scotia Land Surveyor (N.S.L.S.).

11.0 LEGAL PLANS DETAILS

See the following drawing standards figures:

- Drawing Sizes: DS 01;
- Titleblock: DS 06, DS 08, DS 09;
- Linetype: DS 18;
- Legend: DS 19;
- Lot Identifier: DS 20;
- Drawing Layers: Appendix B

12.0 APPENDICES

Appendix A - Layers for Design Drawings

Appendix B - Layers for Legal Drawings

Appendix C - Feature Code (FCODE) Listing

Appendix D - Drawing Standards Index

Municipal Design Guidelines

2021

Part C: Drawing Standards

Appendix A – Layers for Design Drawings



HALIFAX

APPENDIX 'A'

LAYERS FOR DESIGN DRAWINGS

HRMTEMPLATE.DWT/HRMSUBTEMPLATE.DWT

| Layer Name | Description | Linetype | Plot Style |
|------------------------------|---|------------|------------|
| 0 | | Continuous | Width 0.20 |
| BASELINE | Alignment | Centerline | Width 0.20 |
| BUILDING FROM HRM GIS | Building Polygon from HRM GIS | Continuous | Width 0.65 |
| CDIRB | Property Line from HRM GIS: Internal Road Boundary | CDIRB | Width 0.15 |
| CDPL | Property Line from HRM GIS: Property Line | cdpl | Width 0.15 |
| CDRRAB | Property Line from HRM GIS: Arbitrary Road Line | CDRRAB | Width 0.15 |
| CDRRRD | Property Line from HRM GIS: Road Parcel | CDRRRD | Width 0.40 |
| CDWACO | Property Line from HRM GIS: Coast Line | CDWACO | Width 0.15 |
| CORRIDORS SURFACE | Corridor | Continuous | Width 0.20 |
| DEFPOINTS | Definition Points | Continuous | Width 0.30 |
| DLMG | Property Line from HRM GIS: Management Units | Continuous | Width 0.15 |
| FINISHED SURFACE | Finished Surface | Continuous | Width 0.30 |
| GRID | PROFILE: Grid Lines for Profile | Continuous | Width 0.15 |
| GSCD | Natural Gas Conduit from HRM GIS | GSPI | Width 0.15 |
| GSPI | Natural Gas Pipeline from HRM GIS | GSPI | Width 0.15 |
| GSTL | Natural Gas Transmission Line from HRM GIS | GSTL | Width 0.20 |

| Layer Name | Description | Linetype | Plot Style |
|----------------------|--|-------------------------|------------|
| HE-BREAKLINES | RECORD SURVEY: Breaklines for TIN / Back of Curb/ Centerline | Continuous | Width 0.20 |
| HE-BUILDING | RECORD SURVEY: Building Line | bldg | Width 0.18 |
| HE-COMBINED | RECORD SURVEY: Combined Sewer Pipe | SWPICO | Width 0.18 |
| HE-CONTOUR | RECORD SURVEY: Contour Line | Continuous | Width 0.30 |
| HE-DRIVEWAY | RECORD SURVEY: Driveway-Parking-Walkway Line | RRDR or RRPA or RRWK | Width 0.18 |
| HE-FENCE | RECORD SURVEY: Fence Line | STFE | Width 0.15 |
| HE-GAS | RECORD SURVEY: Natural Gas Pipeline | GSPI / GSTL/ GSLA/ GSPE | Width 0.15 |
| HE-HYDRO | RECORD SURVEY: Pitch Lake-Stream-Coast Line | WADI/ WAOH/ WASL/ WAWM | Width 0.15 |
| HE-LABEL-ALL | RECORD SURVEY: All Labels | Continuous | Width 0.20 |
| HE-OTHER | RECORD SURVEY: Miscellaneous Line | Continuous | Width 0.15 |
| HE-PARCELL | RECORD SURVEY: Parcel Line | CDPL | Width 0.15 |
| HE-POINTS-ALL | RECORD SURVEY: All Points | Continuous | Width 0.20 |
| HE-ROAD | RECORD SURVEY: Road Line | RRCB/ RRRD | Width 0.30 |
| HE-SAMPLE | RECORD SURVEY: Section Line of Plan | Continuous | Width 0.20 |
| HE-SANITARY | RECORD SURVEY: Sanitary Sewer Pipe | SWPISA | Width 0.15 |
| HE-SIDEWALK | RECORD SURVEY: Sidewalk Line | RRSW | Width 0.20 |
| HE-SLOPES | RECORD SURVEY: Slope Line | Continuous | Width 0.15 |
| HE-STORM | RECORD SURVEY: Storm Sewer Pipe | SWPIST | Width 0.15 |

| Layer Name | Description | Linetype | Plot Style |
|--------------------------|--------------------------------------|------------|------------|
| HE-STREETLINE | RECORD SURVEY: Edge of Right-of-Way | Continuous | Width 0.40 |
| HE-STRUCTURE | RECORD SURVEY: Structure Line | Continuous | Width 0.15 |
| HE-SURFACE | RECORD SURVEY: Surface for TIN Lines | Continuous | Width 0.30 |
| HE-SYMBOLS-ALL | RECORD SURVEY: All Symbolized Points | Continuous | Width 0.18 |
| HE-TRAFFIC | RECORD SURVEY: Traffic Line | Continuous | Width 0.15 |
| HE-TREE LINE | RECORD SURVEY: Tree Line | Continuous | Width 0.15 |
| HE-UTILITY | RECORD SURVEY: Utility Line | Continuous | Width 0.15 |
| HE-WATER | RECORD SURVEY: Water Pipe | Continuous | Width 0.18 |
| HP-ASSEMBLY | PROPOSED: Assembly Template | Continuous | Width 0.30 |
| HP-COMBINED | PROPOSED: Combined Sewer Pipe | Continuous | Width 0.65 |
| HP-CORRIDOR | PROPOSED: Corridor | Continuous | Width 0.30 |
| HP-CORRIDOR FLINE | PROPOSED: Corridor | Continuous | Width 0.30 |
| HP-LINK | PROPOSED: Assembly Link | Continuous | Width 0.30 |
| HP-ROAD | PROPOSED: Road Line | Continuous | Width 0.65 |
| HP-SANITARY | PROPOSED: Sanitary Sewer Pipe | Continuous | Width 0.65 |
| HP-SIDEWALK | PROPOSED: Sidewalk Line | Continuous | Width 0.40 |
| HP-STORM | PROPOSED: Storm Sewer Pipe | Continuous | Width 0.65 |
| HP-TABLE | PROPOSED: Alignment Table | Continuous | Width 0.30 |
| HRWC-DIM-AND-TEXT | HALIFAX WATER: Dimenions and Text | Continuous | Width 0.30 |
| HRWC-LOGO | HALIFAX WATER: Logo Line | Continuous | Width 0.30 |
| HRWC-LOGO-TXT | HALIFAX WATER: Logo Text | Continuous | Width 0.30 |

| Layer Name | Description | Linetype | Plot Style |
|--|---|------------|------------|
| HRWC HYDRANT FROM HRM GIS | HALIFAX WATER: Hydrant from HRM GIS | Continuous | Width 0.15 |
| HRWC PIPE FROM HRM GIS | HALIFAX WATER: Pipe from HRM GIS | Continuous | Width 0.18 |
| HRWC VALVE FROM HRM GIS | HALIFAX WATER: Valve from HRM GIS | Continuous | Width 0.15 |
| K-ROADANNO | KEYPLAN: Annotation | Continuous | Width 0.20 |
| K-STREET | KEYPLAN: Street Line | Continuous | Width 0.30 |
| K-WAOC10 | KEYPLAN: Water Line | Continuous | Width 0.30 |
| MATCHLINE | Matchline for series of Plans | Continuous | Width 0.65 |
| MISC | TEMPORARY: Miscellaneous Construction Lines | Continuous | Width 0.30 |
| NATURAL GAS SERVICE LATERAL HRM GIS | Natural Gas Service Lateral from HRM GIS | GSLA | Width 0.15 |
| NO PLOT | No Plotting Features | Continuous | Normal |
| POINTS TABLE | Table for Points | Continuous | Width 0.30 |
| Poles | Solid Hatch | Continuous | Poles |
| RRCB | Curbed Road from HRM GIS | RRCB | Width 0.30 |
| RRDR | Driveway from HRM GIS | RRDR | Width 0.18 |
| RRPA | Parking Area from HRM GIS | RRPA | Width 0.18 |
| RRPW | Pathway from HRM GIS | RRPW | Width 0.18 |
| RRRD | Edge of Asphalt from HRM GIS | RRRD | Width 0.30 |
| RRRR | Railroad from HRM GIS | RRRR | Width 0.20 |
| RRSW | Sidewalk from HRM GIS | RRSW | Width 0.20 |
| RRTR | Trail from HRM GIS | RRTR | Width 0.15 |

| Layer Name | Description | Linetype | Plot Style |
|---------------------------------------|--|------------|------------|
| RRWK | Hard Surface Walkway from HRM GIS | RRWK | Width 0.18 |
| SCHEMATIC SEWER FROM HRM GIS | Schematic Sewer from HRM GIS | Continuous | Width 0.15 |
| SEWER INLET FROM HRM GIS | Sewer Inlet-Catchbasin from HRM GIS | Continuous | Width 0.15 |
| SEWER MANHOLE FROM HRM GIS | Sewer Manhole from HRM GIS | Continuous | Width 0.15 |
| SHADE | Solid Hatch for Pave | Continuous | Shade |
| SHEET | Sheet | Continuous | Width 0.8 |
| STFE | Fence Line from HRM GIS | STFE | Width 0.15 |
| STGR | Guiderail Line from HRM GIS | STGR | Width 0.15 |
| STREET CENTRELINE FROM HRM GIS | Key Plan Street Name | | Width 0.20 |
| STREET FROM HRM G/S | Key Plan Street Line | | Width 0.30 |
| STRW | Retaining Wall from HRM GIS | STRW | Width 0.15 |
| STWL | Wall from HRM GIS | STWL | Width 0.15 |
| SWFMAB | Abandoned Sewer Forcemain from HRM GIS | SWFMAB | Width 0.15 |
| SWFMCO | Combined Sewer Forcemain from HRM GIS | SWFMAB | Width 0.15 |
| SWFMSA | Sanitary Sewer Forcemain from HRM GIS | SWFMSA | Width 0.15 |
| SWFMST | Storm Sewer Forcemain from HRM GIS | SWFMST | Width 0.15 |
| SWLACO | Combined Sewer Lateral from HRM GIS | SWLACO | Width 0.15 |

| Layer Name | Description | Linetype | Plot Style |
|-----------------------------------|--|------------|------------|
| SWLASA | Sanitary Sewer Lateral from HRM GIS | SWLASA | Width 0.15 |
| SWLAST | Storm Sewer Lateral from HRM GIS | SWLAST | Width 0.15 |
| SWPICL | Catchbasin Lead from HRM GIS | SWPICL | Width 0.15 |
| SWPICO | Combined Sewer Pipe from HRM GIS | SWPICO | Width 0.15 |
| SWPICOTK | Combined Trunk Sewer Pipe from HRM GIS | SWPICOTK | Width 0.15 |
| SWPISA | Sanitary Sewer Pipe from HRM GIS | SWPISA | Width 0.15 |
| SWPISATK | Sanitary Trunk Sewer Pipe from HRM GIS | SWPISATK | Width 0.15 |
| SWPIST | Storm Sewer Pipe from HRM GIS | SWPIST | Width 0.15 |
| SWPIUK | Unknown Sewer Pipe from HRM GIS | SWPIUK | Width 0.15 |
| TREE FROM HRM GIS | Tree Point from HRM GIS | Continuous | Width 0.15 |
| TREE LINE FROM HRM GIS | Tree Line from HRM GIS | Continuous | Width 0.15 |
| UTFO | Fibre Optic Line from HRM GIS | UTFO | Width 0.15 |
| UTILITY POINT FROM HRM GIS | Utility Point Features from HRM GIS | Continuous | Width 0.15 |
| UTPI | Pipeline from HRM GIS | UTPI | Width 0.15 |
| UTSS | Utility Substation Line from HRM GIS | UTSS | Width 0.15 |
| UTTK | Utility Tank Line from HRM GIS | UTTK | Width 0.15 |
| UTTR | Utility Transmission Line from HRM GIS | UTTR | Width 0.15 |
| UTWT | Utility Water Tank Line from HRM GIS | UTWT | Width 0.15 |

| Layer Name | Description | Linetype | Plot Style |
|------------------------|---|------------|------------|
| VE-COMBINED | PROFILE-EXISTING: Combined Sewer Pipe | Continuous | Width 0.30 |
| VE-PROFILE | PROFILE-EXISTING: Ground | Continuous | Width 0.30 |
| VE-SANITARY | PROFILE-EXISTING: Sanitary Sewer Pipe | Continuous | Width 0.30 |
| VE-SECTION | CROSS SECTION-EXISTING: Section View | Continuous | Width 0.30 |
| VE-SECTION-DATA | CROSS SECTION-EXISTING: Ground Line | Continuous | Width 0.30 |
| VE-SECTION-PIPE | CROSS SECTION-EXISTING: Pipe | Continuous | Width 0.30 |
| VE-STORM | PROFILE-EXISTING: Storm Sewer Pipe | Continuous | Width 0.30 |
| VE-WATER | PROFILE-EXISTING: Water Pipe | waterprof | Width 0.30 |
| VIEW | MODEL VIEW: Polyline for Window | Continuous | Width 0.15 |
| VP-COMBINED | PROFILE-PROPOSED: Combined Sewer Pipe | Continuous | Width 0.53 |
| VP-PROFILE | PROFILE-PROPOSED: Ground | Continuous | Width 0.53 |
| VP-SANITARY | PROFILE-PROPOSED: Sanitary Sewer Pipe | Continuous | Width 0.53 |
| VP-SECTION-DATA | CROSS SECTION-PROPOSED: Section Ground Line | Continuous | Width 0.53 |
| VP-STORM | PROFILE-PROPOSED: Storm Sewer Pipe | Continuous | Width 0.53 |
| WIDTH 0.15 | MISCELLANEOUS TEXT-LINE: Plot @ Line Weight 0.15 NOT RECORD | Continuous | Width 0.15 |
| WIDTH 0.2 | MISCELLANEOUS TEXT-LINE: Plot @ Line Weight 0.2 NOT RECORD | Continuous | Width 0.20 |
| WIDTH 0.3 | MISCELLANEOUS TEXT-LINE: Plot @ Line Weight 0.3 NOT RECORD | Continuous | Width 0.30 |

| Layer Name | Description | Linetype | Plot Style |
|-------------------|---|------------|------------|
| WIDTH 0.4 | MISCELLANEOUS TEXT-LINE: Plot @ Line Weight 0.4 NOT RECORD | Continuous | Width 0.40 |
| WIDTH 0.8 | MISCELLANEOUS TEXT-LINE: Plot @ Line Weight 0.8 NOT RECORD | Continuous | Width 0.80 |
| WIDTH 0.53 | MISCELLANEOUS TEXT-LINE: Plot @ Line Weight 0.53 NOT RECORD | Continuous | Width 0.53 |
| WIDTH 0.65 | MISCELLANEOUS TEXT-LINE: Plot @ Line Weight 0.65 NOT RECORD | Continuous | Width 0.65 |
| WIDTH 1.06 | MISCELLANEOUS TEXT-LINE: Plot @ Line Weight 1.06 NOT RECORD | Continuous | Width 1.06 |
| WIDTH 1.4 | MISCELLANEOUS TEXT-LINE: Plot @ Line Weight 1.4 NOT RECORD | Continuous | Width 1.4 |

Municipal Design Guidelines

2021

Part C: Drawing Standards

Appendix B – Layers for Legal Drawings

APPENDIX 'B'

LAYERS FOR LEGAL DRAWINGS HRMLEGALTEMPLATE.DWT

| Layer | Description | Linetype | Plot Style |
|-----------------------|---|-------------------------|------------|
| 0 | Miscellaneous | Continuous | Width 0.20 |
| CALCP | Calculated Points | Continuous | Width 0.20 |
| HE-BUILDING | Lines from Survey: Building | Continuous | Width 0.20 |
| HE-DRIVEWAY | Lines from Survey: Driveway/Parking/Walkway Line | RRDR/RRPA/ RRWK | Width 0.20 |
| HE-FENCE | Lines from Survey: Fence | STFE | Width 0.20 |
| HE-GAS | Lines from Survey: Gas | GSPI | Width 0.20 |
| HE-HYDRO | Lines from Survey: Stream/Lake/Coast | WADI/WAOH/ WASL/WAWM | Width 0.20 |
| HE-OTHER | Lines from Survey: Miscellaneous Line | Continuous | Width 0.20 |
| HE-PARCEL | Lines from Survey: Adjoining Parcels | Continuous | Width 0.25 |
| HE-POINTS-ALL | All Points from Survey | Continuous | Width 0.20 |
| HE-ROAD | Lines from Survey: Curb & Sidewalk | Continuous | Width 0.20 |
| HE-RRRR | Lines from Survey: Railway Lines | RRRR | Width 0.20 |
| HE-STRUCTURE | Lines from Survey: Structure Line | Continuous | Width 0.20 |
| HE-SURVEY | Boundaries dealt with by this survey. | Continuous | Width 0.80 |
| HE-SYMBOLS-ALL | All Symbolized Points from Survey | Continuous | Width 0.20 |
| HE-TRAFFIC | Lines from Survey: Traffic Lights, Lines & Signs | Continuous | Width 0.20 |
| HE-TREE LINE | Lines from Survey: Tree, Hedge, Tree Line | Cont./LCHG | Width 0.20 |
| HE-UTILITY | Lines from Survey: Pole & other Utility features | Continuous | Width 0.20 |

| | | | |
|-------------------|---|------------|------------|
| HE-WATER | Lines from Survey: Valve, Hydrant, Pipe, etc. | Continuous | Width 0.20 |
| NO PLOT | No Plotting Features | Continuous | Normal |
| SHADE | Shading using Solid | Continuous | Shade |
| SHEET | Sheet | Continuous | Width 0.80 |
| SURVEYP | Survey Points from Survey: Evidence, Monumentation & Control Points | Continuous | Width 0.30 |
| VIEW | Polyline for Viewport | Continuous | Width 0.15 |
| WIDTH 0.2 | Miscellaneous text-line: Plot @ Line Weight 0.2 | Continuous | Width 0.20 |
| WIDTH 0.3 | Miscellaneous text-line: Plot @ Line Weight 0.3 | Continuous | Width 0.30 |
| WIDTH 0.4 | Miscellaneous text-line: Plot @ Line Weight 0.4 | Continuous | Width 0.40 |
| WIDTH 0.53 | Miscellaneous text-line: Plot @ Line Weight 0.53 | Continuous | Width 0.53 |
| WIDTH 0.65 | Miscellaneous text-line: Plot @ Line Weight 0.65 | Continuous | Width 0.65 |
| WIDTH 0.8 | Miscellaneous text-line: Plot @ Line Weight 0.8 | Continuous | Width 0.80 |
| WIDTH 1.06 | Miscellaneous text-line: Plot @ Line Weight 1.06 | Continuous | Width 1.06 |
| WIDTH 1.4 | Miscellaneous text-line: Plot @ Line Weight 1.4 | Continuous | Width 1.4 |

Municipal Design Guidelines

2021

Part C: Drawing Standards

Appendix C – Feature Code (FCODE) Listing

APPENDIX 'C'

FEATURE CODE (FCODE) LISTING

| FCODE | DESCRIPTION | Symbol Type | Symbol | DWG Layer - RECORD SURVEY | DWG Layer - Extracted from HRM GIS |
|-------------|----------------------------------|-------------------------|-------------------|---------------------------|------------------------------------|
| ROAD | | | | | |
| RRCB | Curbed Road | Linetype / Linear | rrcb, _____ | HE-ROAD | RRCB |
| RRCB-A | Curb Top Back-Asphalt | Linetype / Linear | rrcb-a, _____ | HE-BREAKLINES | RRCB |
| RRCB-C | Curb Top Back - Concrete | Linetype / Linear | rrcb-c, _____ | HE-BREAKLINES | RRCB |
| RRCC | Driveway Cut | Point / Block Reference | X | HE-POINTS-ALL | N/A |
| RRCL | Centreline | Linetype / Linear | RRCL, _____ | HE-BREAKLINES | RRCL |
| RRDR | Driveway | Linetype / Linear | rrdr, _____ | HE-DRIVEWAY | RRDR |
| RRDR-A | Driveway - Asphalt | Linetype / Linear | RRDR-A, _____ | HE-DRIVEWAY | RRDR |
| RRDR-B | Driveway - Brick | Linetype / Linear | RRDR-B, _____ | HE-DRIVEWAY | RRDR |
| RRDR-C | Driveway - Concrete | Linetype / Linear | RRDR-C, _____ | HE-DRIVEWAY | RRDR |
| RRDR-G | Driveway - Gravel | Linetype / Linear | RRDR-G, - - - - - | HE-DRIVEWAY | RRDR |
| RRGT-A | Gutter-Asphalt | Linetype / Linear | rrcb-a, _____ | HE-ROAD | RRCB |
| RRGT-C | Gutter-Concrete | Linetype / Linear | rrcb-c, _____ | HE-ROAD | RRCB |
| RRJB | Jersey Barrier | Linetype / Linear | RRJB, _____ | HE-ROAD | RRJB |
| RRPA-A | Parking Area - Asphalt | Linetype / Linear | rrpa-a, _____ | HE-DRIVEWAY | RRPA |
| RRPA-C | Parking Area-Concrete | Linetype / Linear | rrpa, _____ | HE-DRIVEWAY | RRPA |
| RRPA-G | Parking Area - Gravel | Linetype / Linear | rrpa-g, _____ | HE-DRIVEWAY | RRPA |
| RRPW | Pathway | Linetype / Linear | rrpw, _____ | HE-DRIVEWAY | RRPW |
| RRRD | Edge of Road (no curb) | Linetype / Linear | rrrd, _____ | HE-ROAD | RRRD |
| RRRD-A | Edge of Road - Asphalt (no curb) | Linetype / Linear | rrrd-a, _____ | HE-ROAD | RRRD |
| RRRD-G | Edge of Road - Gravel (no curb) | Linetype / Linear | rrrd-g, _____ | HE-ROAD | RRRD |
| RRRR | Railroad | Linetype / Linear | RRRR, _____ | HE-OTHER | RRRR |
| RRRRSW | Railroad Switch | Point / Block Reference | X | HE-POINTS-ALL | N/A |
| RRSH-G | Shoulder - Gravel | Linetype / Linear | RRSH-G, - - - - - | HE-ROAD | N/A |
| RRSW | Sidewalk | Linetype / Linear | rrsw, _____ | HE-SIDEWALK | RRSW |
| RRSW-A | Sidewalk - Asphalt | Linetype / Linear | rrsw-a, _____ | HE-SIDEWALK | RRSW |
| RRSW-B | Sidewalk - Brick | Linetype / Linear | rrsw-b, _____ | HE-SIDEWALK | RRSW |
| RRSW-C | Sidewalk - Concrete | Linetype / Linear | rrsw-c, _____ | HE-SIDEWALK | RRSW |
| RRWK | Walkway | Linetype / Linear | rrwk, _____ | HE-DRIVEWAY | RRWK |
| RRWK-A | Walkway - Asphalt | Linetype / Linear | rrwk-a, _____ | HE-DRIVEWAY | RRWK |
| RRWK-B | Walkway - Brick | Linetype / Linear | rrwk-b, _____ | HE-DRIVEWAY | RRWK |
| RRWK-C | Walkway - Concrete | Linetype / Linear | rrwk-c, _____ | HE-DRIVEWAY | RRWK |
| RRWK-G | Walkway - Gravel | Linetype / Linear | rrwk-g, - - - - - | HE-DRIVEWAY | RRWK |

| FENCE | | | | | |
|-----------|---------------------------|-------------------------|--|---------------|---|
| STFE | Fence | Linetype / Linear | stfe,---- X ---- X ---- | HE-FENCE | STFE |
| STFE-CH | Fence - Chainlink | Linetype / Linear | stfe-ch,---- X ---- X ---- | HE-FENCE | STFE |
| STFE-WR | Fence - Wire | Linetype / Linear | stfe-wr,---- X ---- X ---- | HE-FENCE | STFE |
| STFE-WD | Fence - Wood | Linetype / Linear | stfe-wd,---- X ---- X ---- | HE-FENCE | STFE |
| STGR | Guiderail | Linetype / Linear | STGR,---- GR ---- GR - | HE-FENCE | STFE |
| STGT | Fence - Gate | Linetype / Linear | STGT, _____ | HE-FENCE | STFE |
| STPT | Fence - Post | Point / Block Reference | X | HE-POINTS-ALL | STPT |
| STWL | Wall | Linetype / Linear | stwl,---- W ---- W ---- | HE-FENCE | STWL |
| STRUCTURE | | | | | |
| STBB | Billboard | Linetype / Linear | STBB, _____ | HE-STRUCTURE | Structure Line from HRM GIS |
| STBL | Bleachers | Linetype / Linear | STBL, _____ | HE-STRUCTURE | Structure Line from HRM GIS |
| STCO | Column\Pillar | Linetype / Linear | STCO, _____ | HE-STRUCTURE | Structure Line from HRM GIS |
| STDK | Deck | Linetype / Linear | STDK, _____ | HE-STRUCTURE | Structure Line from HRM GIS |
| STFL | Fountain | Linetype / Linear | STFL, _____ | HE-STRUCTURE | Structure Line from HRM GIS |
| STGP | Guard Post/Bollard | Point / Block Reference | X | HE-POINTS-ALL | STGP |
| STGT | Gate | Linetype / Linear | STGT, _____ | HE-STRUCTURE | Structure Line from HRM GIS |
| STHW | Concrete Headwall | Point / Block Reference |  SWHW | HE-STRUCTURE | Collection System Headwall from HRM GIS |
| STHW | Concrete Headwall | Linetype / Linear | STHW, --- HW--- HW-- | HE-STRUCTURE | Structure Line from HRM GIS |
| STMB | Community Mailbox | Linetype / Linear | STMB, _____ | HE-STRUCTURE | Structure Line from HRM GIS |
| STMO | Monument/Statue | Linetype / Linear | STMO, _____ | HE-STRUCTURE | Structure Line from HRM GIS |
| STN | Stone/Rock | Linetype / Linear | STN, _____ | HE-STRUCTURE | Structure Line from HRM GIS |
| STPR | Pier (bridge support) | Linetype / Linear | STPR, _____ | HE-STRUCTURE | Structure Line from HRM GIS |
| STRW | Retaining Wall | Linetype / Linear | strw,---- RW ---- RW --- | HE-STRUCTURE | STRW |
| STRW-C | Retaining Wall - Concrete | Linetype / Linear | strw-c,---- RW ---- RW - | HE-STRUCTURE | STRW |
| STRW-B | Retaining Wall - Brick | Linetype / Linear | strw-b,---- RW ---- RW - | HE-STRUCTURE | STRW |
| STRW-G | Retaining Wall - Gabion | Linetype / Linear | STRW-G--- RW --- RW | HE-STRUCTURE | STRW |
| STRW-WD | Retaining Wall - Wood | Linetype / Linear | STRW-WD,--- RW-- RW | HE-STRUCTURE | STRW |
| STRW-R | Retaining Wall - Rock | Linetype / Linear | STRW-R--- RW --- RW | HE-STRUCTURE | STRW |

| | | | | | |
|-------------------|-----------------------------------|-------------------------|--|----------------|-----------------------------|
| STSB | Concrete Slab | Linetype / Linear | STSB, _____ | HE-STRUCTURE | Structure Line from HRM GIS |
| STST | Steps | Linetype / Linear | STST, _____ | HE-STRUCTURE | Structure Line from HRM GIS |
| STST-C | Steps - Concrete | Linetype / Linear | STST-C, _____ | HE-STRUCTURE | Structure Line from HRM GIS |
| STST-WD | Steps - Wood | Linetype / Linear | STST-WD, _____ | HE-STRUCTURE | Structure Line from HRM GIS |
| STWH | Wharf | Linetype / Linear | STWH, _____ | HE-STRUCTURE | Structure Line from HRM GIS |
| STUN | Unknown Structure | Linetype / Linear | STUN, _____ | HE-STRUCTURE | Structure Line from HRM GIS |
| TWSI | Tactile Walking Surface Indicator | Point / Block Reference |  TWSI | HE-SYMBOLS-ALL | T.W.S.I. from HRM GIS |
| VEGETATION | | | | | |
| LCSA | Shrub Area | Linetype / Linear | LCSA, _____ | HE-TREE LINE | Tree Line from HRM GIS |
| LCSA | Shrub | Point / Block Reference |  SHRUB | HE-SYMBOLS-ALL | N/A |
| LCCG | Cultivated Garden | Linetype / Linear | LCCG, _____ | HE-TREE LINE | Tree Line from HRM GIS |
| LCHG | Hedge | Linetype / Linear | lchg, --- H --- H --- | HE-TREE LINE | Tree Line from HRM GIS |
| LCGR | Edge of Grass | Linetype / Linear | LCGR, _____ | HE-TREE LINE | Tree Line from HRM GIS |
| LCPL | Planter | Linetype / Linear | LCPL, _____ | HE-STRUCTURE | Tree Line from HRM GIS |
| LCTR | Tree Line Breakline | Linetype / Linear | LCTR, _____ | HE-TREE LINE | Tree Line from HRM GIS |
| LCTS | Tree | Point / Block Reference |  LCTL | HE-SYMBOLS-ALL | Tree from HRM GIS |
| LCTS | Tree Line | Linetype / Linear | LCTR, _____ | HE-TREE LINE | Tree Line from HRM GIS |
| TRAFFIC | | | | | |
| BKS | Bike Lane Symbol | Point / Block Reference |  BKS | HE-SYMBOLS-ALL | N/A |
| BUS | Bus Lane Symbol | Point / Block Reference |  TFMKRL | HE-SYMBOLS-ALL | N/A |
| TFCDL | U/G Street Light Conduit | Linetype / Linear | TFCDL, ---SL --- SL --- | HE-TRAFFIC | N/A |
| TFBS | Bus Shelter | Linetype / Linear | trbssh, _____ | HE-TRAFFIC | Bus Shelter from HRM GIS |
| TFBT | Bus Stop | Point / Block Reference |  BUS | HE-SYMBOLS-ALL | Bus Stop from HRM GIS |
| TFCDTL | U/G Traffic Light Conduit | Linetype / Linear | tfcdtl, ----TL----TL---- | HE-TRAFFIC | N/A |
| TFCDFA | U/G Fire Alarm Conduit | Linetype / Linear | tfcdfa, ----FA----FA---- | HE-TRAFFIC | N/A |
| TFDL | Detector Loop | Linetype / Linear | TFDL, _____ | HE-TRAFFIC | N/A |
| TFMKAC | Advanced Cross Walk | Point / Block Reference |  TFTL | HE-SYMBOLS-ALL | N/A |
| TFMKCW | Cross Walk | Linetype / Linear | tfmkcw, _____ | HE-TRAFFIC | N/A |
| TFMKCL | Center Line Pavement Marking | Linetype / Linear | tfmkcl, _____ | HE-TRAFFIC | N/A |
| TFMKCM | Channel Marking | Linetype / Linear | tfmkcm, _____ | HE-TRAFFIC | N/A |

| | | | | | |
|----------------|--|-------------------------|--|----------------|---------------------------|
| TFMKSB | Stop Bar | Linetype / Linear | tfmksb, _____ | HE-TRAFFIC | N/A |
| TFMKMM | Parking Meter Lines | Linetype / Linear | tfmkmm, _____ | HE-TRAFFIC | N/A |
| TFMKDL | Dashed Line | Linetype / Linear | tfmkdl, _____ | HE-TRAFFIC | N/A |
| TFMKDY | Double Yellow Line | Linetype / Linear | tfmkdy, _____ | HE-TRAFFIC | N/A |
| TFMKSY | Single Yellow Line | Linetype / Linear | tfmkdy, _____ | HE-TRAFFIC | N/A |
| TFMKWS | Single White Line | Linetype / Linear | tfmksw, _____ | HE-TRAFFIC | N/A |
| TFJB | Traffic Loop Junction Box | Point / Block Reference |  JB TFJB | HE-SYMBOLS-ALL | N/A |
| TFPM | Parking Pay Station | Point / Block Reference |  PM TFPM | HE-SYMBOLS-ALL | TFPM |
| TFCB | Traffic Cabinet or Controller Box | Point / Block Reference |  TFCB | HE-SYMBOLS-ALL | N/A |
| TFSL | Street Light Standard | Point / Block Reference |  TFSL | HE-SYMBOLS-ALL | Streetlights from HRM GIS |
| TFSLOR | Ornamental Street Light Standard | Point / Block Reference |  TFSLOR | HE-SYMBOLS-ALL | N/A |
| TFSP | Sign -Multiple Posts | Linetype / Linear | TFSP, _____ | HE-TRAFFIC | N/A |
| TFSP | Sign Post | Point / Block Reference |  TFSP | HE-SYMBOLS-ALL | TFSP |
| TFAR3T | Pavement Marking - 3 turn arrow | Point / Block Reference |  TFMKAR3T | HE-SYMBOLS-ALL | N/A |
| TFMARRL | Pavement Marking - right/left arrow | Point / Block Reference |  TFMKARRLT | HE-SYMBOLS-ALL | N/A |
| TFMARLT | Pavement Marking - left turn only | Point / Block Reference |  TFMKARLT | HE-SYMBOLS-ALL | N/A |
| TFARRT | Pavement Marking - right turn only | Point / Block Reference |  TFMKARRT | HE-SYMBOLS-ALL | N/A |
| TFARST | Pavement Marking - straight only | Point / Block Reference |  TFMKARST | HE-SYMBOLS-ALL | N/A |
| TFARTR | Pavement Marking - straight/right turn | Point / Block Reference |  TFMKARTR | HE-SYMBOLS-ALL | N/A |
| TFARTL | Pavement Marking - straight/left turn | Point / Block Reference |  TFMKARTL | HE-SYMBOLS-ALL | N/A |
| TFTL | Traffic Light Standard | Point / Block Reference |  TFTL | HE-SYMBOLS-ALL | Traffic Pole from HRM GIS |
| UTILITY | | | | | |
| UTGW | Guy Wire | Linetype / Linear | UTGW, _____ | HE-UTILITY | N/A |
| UTGW | Guy Wire Anchor | Point / Block Reference |  UTGW | HE-SYMBOLS-ALL | N/A |
| UTCDDL | U/G Communication Conduit | Linetype / Linear | UTCDDL,----TD ---- TD | HE-UTILITY | N/A |
| UTCDDPW | U/G Electrical Conduit | Linetype / Linear | UTCDDPW,----ET ---- ET | HE-UTILITY | N/A |
| UTOH | Overhead Wires | Linetype / Linear | UTOH, ___ . ___ . | HE-UTILITY | UTTR |
| UTTK | Tank (oil, propane, etc.) | Linetype / Linear | UTTK, _____ | HE-UTILITY | UTTK |

| | | | | | |
|-----------------|----------------------------------|-------------------------|--|----------------|---------------------------------|
| UTTR | Telephone Pedestal | Linetype / Linear | UTTR, _____ | HE-UTILITY | UTTR |
| UTTB | Telephone Booth | Linetype / Linear | UTTB, _____ | HE-UTILITY | UTTB |
| UTJB | Junction Box | Linetype / Linear | UTJB, _____ | HE-UTILITY | UTJB |
| UTMHPW | NS Power Manhole or Junction Box | Point / Block Reference |  UTMHPW | HE-SYMBOLS-ALL | Utility Point from HRM GIS |
| UTPO | Utility Pole | Point / Block Reference |  UTPO | HE-SYMBOLS-ALL | Utility Point from HRM GIS |
| UTFO | Fibre Optic Line | Linetype / Linear | UTFO, ----- | HE-OTHER | UTFO |
| UTMHTL | Aliant Manhole | Point / Block Reference |  UTMHTL | HE-SYMBOLS-ALL | N/A |
| GAS | | | | | |
| GSPI | Gas Line | Linetype / Linear | GSPI, —G—G— | HE-GAS | GSPI |
| GSLA | Gas Lateral | Linetype / Linear | GSLA, _____ | HE-GAS | GSLA |
| GSMT | Gas Meter | Point / Block Reference | X | HE-SYMBOLS-ALL | GSMT |
| GSMH | Gas Manhole | Point / Block Reference |  GSMH | HE-SYMBOLS-ALL | N/A |
| GSTEE | Gas Tee | Point / Block Reference | X | HE-SYMBOLS-ALL | N/A |
| GSVL | Gas Valve | Point / Block Reference |  GSVL | HE-SYMBOLS-ALL | Natural Gas Valves from HRM GIS |
| SLOPE | | | | | |
| LFBL | Miscellaneous Breakline | Linetype / Linear | LFBL, _____ | HE-BREAKLINES | N/A |
| LFTS | Top of Slope | Linetype / Linear | LFTS, _____ | HE-SLOPES | N/A |
| LFBS | Bottom of Slope | Linetype / Linear | LFBS, _____ | HE-SLOPES | N/A |
| LFSH | Spot Elevation | Point / Block Reference | X | HE-POINTS-ALL | N/A |
| LFFE | Finish Floor Elevation | Point / Block Reference | X | HE-POINTS-ALL | N/A |
| STRW-TOP | Top of Retaining Wall | Linetype / Linear | STRW, _____ | HE-BREAKLINES | N/A |
| STRW-BOTTOM | Bottom of Retaining Wall | Linetype / Linear | STRW, _____ | HE-BREAKLINES | N/A |
| BUILDING | | | | | |
| BLDG | Building – No Elevation | Linetype / Linear | bldg, _____ | HE-BUILDING | Building Polygon from HRM GIS |
| BLDGOT | Building - Other | Linetype / Linear | bldg, _____ | HE-BUILDING | Building Polygon from HRM GIS |
| BLDG-B | Building - Brick | Linetype / Linear | BLDG-B, _____ | HE-BUILDING | Building Polygon from HRM GIS |
| BLDG-DR | Building – Door Sill | Point / Block Reference | X | HE-POINTS-ALL | N/A |
| BLDG-FD | Building - Foundation | Linetype / Linear | BLDG-FD, _____ | HE-BUILDING | Building Polygon from HRM GIS |
| BLDG-SD | Building - Siding | Linetype / Linear | BLDG-SD, _____ | HE-BUILDING | Building Polygon from HRM GIS |
| BLDG-SH | Building - Shingles | Linetype / Linear | BLDG-SH, _____ | HE-BUILDING | Building Polygon from HRM GIS |

| | | | | | |
|-------------------|-------------------------|-------------------------|--|----------------|------------------------------|
| BLDG-WS | Building – Window Sill | Point / Block Reference | X | HE-POINTS-ALL | N/A |
| RECREATION | | | | | |
| DAPG | Playground | Linetype / Linear | DAPG, _____ | HE-OTHER | Recreation Area from HRM GIS |
| HYDRO | | | | | |
| WADI | Ditch | Linetype / Linear | WADI, _____ - - - | HE-HYDRO | Ditch from HRM GIS |
| WAOH | Ordinary High Watermark | Linetype / Linear | WAOH, _____ | HE-HYDRO | N/A |
| WASL | Shore Line | Linetype / Linear | WASL, _____ | HE-HYDRO | Lake from HRM GIS |
| WAST | Edge of Stream or Brook | Linetype / Linear | WAST, _____ | HE-HYDRO | N/A |
| SURVEY | | | | | |
| CALC | Calculated Point | Point / Block Reference | X | HE-POINTS-ALL | N/A |
| NSCM | NS Coordinate Monument | Point / Block Reference |  MNNSCM | HE-SYMBOLS-ALL | Survey Monument from HRM GIS |
| RRST | Streetline Tie | Point / Block Reference | X | HE-POINTS-ALL | N/A |
| SVAI | Angle Iron | Point / Block Reference | O | HE-SYMBOLS-ALL | N/A |
| SVBT | Blazed Tree | Point / Block Reference | X | HE-POINTS-ALL | N/A |
| SVCC | Cut Cross | Point / Block Reference |  XCIR | HE-SYMBOLS-ALL | N/A |
| SVCNCM | Concrete Monument | Point / Block Reference |  MNNSCM | HE-SYMBOLS-ALL | N/A |
| SVDH | Drill Hole | Point / Block Reference |  SVDH | HE-SYMBOLS-ALL | N/A |
| SVIB | Iron Bar | Point / Block Reference |  SVIB | HE-SYMBOLS-ALL | N/A |
| SVIP | Iron Pipe | Point / Block Reference |  SVIP | HE-SYMBOLS-ALL | N/A |
| SVNL | Nail in Disk | Point / Block Reference |  SVNL | HE-SYMBOLS-ALL | N/A |
| SVPS | Stone Pile | Point / Block Reference | X | HE-POINTS-ALL | N/A |
| SVRP | Rock Post | Point / Block Reference |  SVRP | HE-SYMBOLS-ALL | N/A |
| SVRS | Railway Spike | Point / Block Reference |  SVRR | HE-SYMBOLS-ALL | N/A |
| SVSK | Survey Spike | Point / Block Reference |  SVSK | HE-SYMBOLS-ALL | N/A |
| SVSM | Survey Marker | Point / Block Reference |  SVSM | HE-SYMBOLS-ALL | N/A |
| SVWP | Wood Post | Point / Block Reference | X | HE-POINTS-ALL | N/A |
| WATER | | | | | |
| WAWL | Water Well | Point / Block Reference | X | HE-POINTS-ALL | N/A |
| WCCHMH | Halifax Water Manhole | Point / Block Reference |  WCCHMH | HE-SYMBOLS-ALL | HRWC Manhole from HRM GIS |

| | | | | | | |
|--------------------|------------------------|-------------------------|---|-------|----------------|--|
| WCHY | HRWC Fire Hydrant | Point / Block Reference |  | WCHY | HE-SYMBOLS-ALL | HRWC Hydrant from HRM GIS |
| WCMW | Monitor Well | Point / Block Reference |  | MWELL | HE-SYMBOLS-ALL | HRWC MW from HRM GIS |
| WCVL | HRWC Water Valve | Point / Block Reference |  | WCVL | HE-SYMBOLS-ALL | HRWC Valve from HRM GIS |
| WCWM | Underground Water Pipe | Linetype / Linear | WCWM, _____ | | HE-WATER | HRWC PIPE FROM HRM GIS |
| CNLM | Limits of Construction | Point / Block Reference |  | CNLM | HE-SYMBOLS-ALL | N/A |
| SEWER/STORM | | | | | | |
| SWCB | Catch Basin | Point / Block Reference |  | SWCB | HE-SYMBOLS-ALL | Collection System Catchbasin from HRM GIS |
| SWCU | Culvert | Point / Block Reference |  | SWCU | HE-SYMBOLS-ALL | N/A |
| SWCU | Underground Storm Pipe | Linetype / Linear | swcu, _____ | | HE-STORM | SWCU |
| SWIN | Culvert Inlet | Point / Block Reference |  | SWCU | HE-SYMBOLS-ALL | N/A |
| SWMH | Manhole | Point / Block Reference |  | SWMHT | HE-SYMBOLS-ALL | Collection System Manhole from HRM GIS |
| SWOF | Culvert Outfall | Point / Block Reference |  | SWCU | HE-SYMBOLS-ALL | HWADM_ HWCS_ OUTFALL |
| SWPI | Underground Sewer Pipe | Linetype / Linear | swpisa, _____ | | HE-SEWER | SWPISA |
| SWPI-PVC | PVC Pipe | Linetype / Linear | SWPIPVC, _____ | | HE-SEWER | SWPISA |
| SWPI-VENT | Vent Pipe | Linetype / Linear | SWPIVP, _____ | | HE-SEWER | N/A |
| SWPS | Pump Station | Point / Block Reference |  | SWPS | HE-SYMBOLS-ALL | Collection System Pumping Station from HRM GIS |

Municipal Design Guidelines

2021

Part C: Drawing Standards

Appendix D: Drawing Standards



HALIFAX

Part C – Appendix D: Drawing Standards

Contents

| | |
|---------|--|
| DS 01 | Standard Drawings Sizes |
| DS 02 | Drawing Sheets Format for Sizes and Layout |
| DS 03 | Folding of Paper Prints |
| DS 04 | Title Block – Type 1 Showing Block Dimensions |
| DS 05 | Title Block – Type 1 Showing Layer, Height and Style |
| DS 06 | Title Block Legal Plans Showing Block Dimensions |
| DS 07 | Title Block for Developers Used For Subdivisions Showing Layer, Height and Style |
| DS 08 | Title Block Legal Plans Showing Text Heights |
| DS 09 | Title Block Legal Plans Showing Block Dimensions |
| DS 10 | Standard Drawings Symbols Plan |
| DS 11 | Standard Drawings Symbols Plan |
| DS 12 | Control Tables (Showing Information for Project Layout) |
| DS 13.1 | Pavement Marking Table (Paint) |
| DS 13.2 | Pavement Marking Table (Thermoplastic) |
| DS 14 | Plan Hatching Layers and Linetypes |
| DS 15 | Plan Text Sizes, Layers, and Linetypes |
| DS 16 | <i>Retired Detail</i> |
| DS 17 | Profile Text Sizes, Layers and Linetypes |
| DS 18 | Profile Text Sizes, Layers and Linetypes |
| DS 19 | Linetypes for Legal Drawings |
| DS 20 | Legend for Legal Drawings |
| DS 21 | Lot Identifiers & Text Sizes for Legal Drawings |
| DS 22 | Legend for Typical Plan & Profile |
| DS 23 | Legend for Typical Record Drawing |
| DS 24 | Notes for Typical Plan & Profile |

ENGINEERING DRAWING STANDARDS

—— DRAWING SIZES ——

STANDARD DRAWING SIZES BASIS FOR SIZES

METRIC DRAWING SIZES ARE BASED ON THE A0 SIZE, HAVING AN AREA OF ONE SQUARE METRE, AND A LENGTH-TO-WIDTH RATIO OF ONE TO ROOT TWO. EACH SMALLER SIZE HAS AN AREA OF ONE HALF OF THE PRECEDING SIZE, AND THE LENGTH-TO-WIDTH RATIO REMAINS CONSTANT.

INSIDE BORDER: THE INSIDE BORDER ENCLOSSES THE WORKING AREA, INCLUDING THE TITLE BLOCK AND OTHER TABLES.

TRIMMED SIZE: TRIMMED SIZE IS THE NOMINAL SIZE OF THE DRAWING WHICH INCLUDES A MARGIN OUTSIDE THE BORDER, AND IS THE SIZE TO WHICH THE FINISHED PRINTS ARE TRIMMED.

NOTE:

ALL ENGINEERING DESIGN DRAWINGS ARE TO BE CREATED USING A-1 SIZE SHEET. STANDARD DRAWING SIZES ARE INCLUDED IN HRMTEMPLATE.dwt.

| LAYOUT NAME | DRAWING SIZE | MILLIMETRES | | | |
|---|--------------|--------------|------|---------------|------|
| | | TRIMMED SIZE | | INSIDE BORDER | |
| | | Y | V | X | W |
| | A3* | 297 | 420 | 277 | 400 |
| | A2* | 420 | 594 | 400 | 574 |
| | A0* | 841 | 1189 | 821 | 1169 |
| A1 | A1 | 594 | 841 | 574 | 821 |
| A1+ | A1+ | 594 | 1189 | 574 | 1169 |
| * FOR LEGAL PLANS | | | | | |
| <p><u>NOTE:</u> WHEN DRAWINGS LARGER THAN A0 ARE REQUIRED, THE DRAWINGS SHALL HAVE A WIDTH (Y) OF 841 mm AND A LENGTH IN INCREMENTS OF 210 mm</p> | | | | | |

HALIFAX

DRAWING STANDARDS

STANDARD DRAWING SIZES

| | | | |
|--------|------|-----------|--------------------------|
| DATE: | 2021 | REFERENCE | APPROVED |
| SCALE: | NTS | | FIG No.: DS 01 |

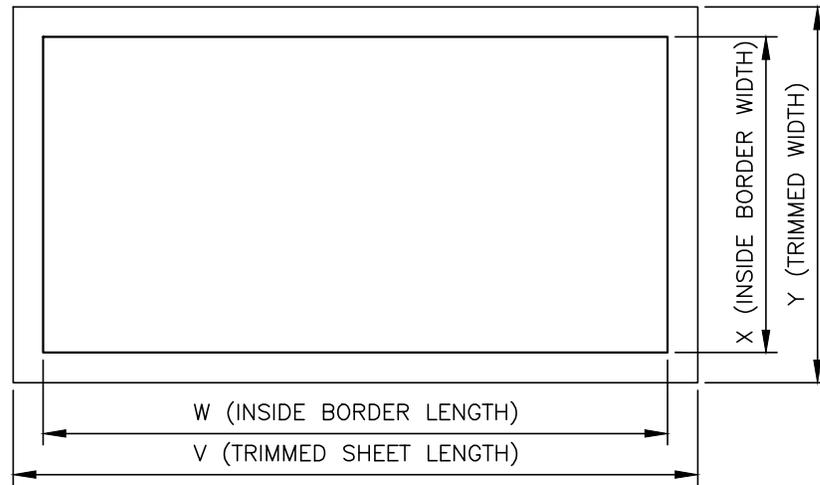


FIGURE 1

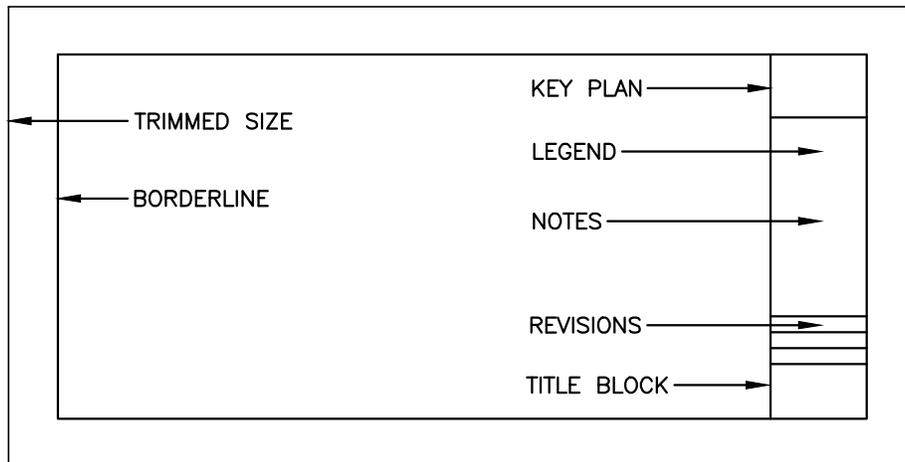



FIGURE 2

HALIFAX


DRAWING STANDARDS

**DRAWING SHEETS FORMAT
FOR SIZES AND LAYOUT**


| | | | |
|--------|------|-----------|-------------------|
| DATE: | 2021 | REFERENCE | APPROVED |
| SCALE: | NTS | | FIG No.: DS 02 |

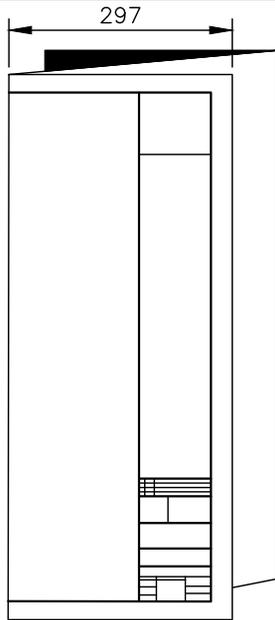

FOLD 1 & 2

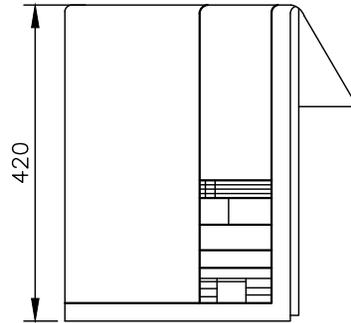


FOLD 3

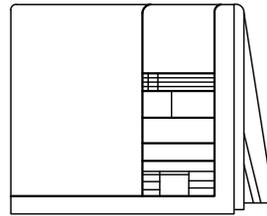


FOLD 4

SIZE A1, A1+ & A0

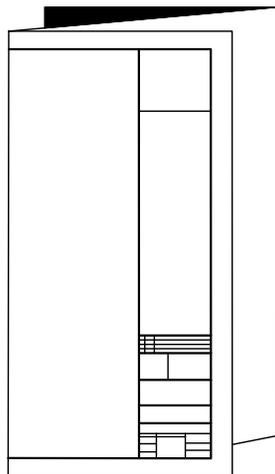


FOLD 1

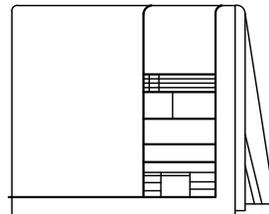

FOLD 2

SIZE A2

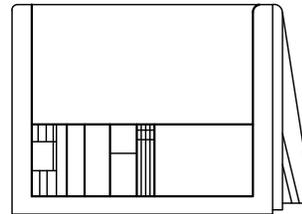

SIZE A3

FOLDING OF PRINTS:

1. TO FACILITATE HANDLING, MAILING, AND FILING, PRINTS SHOULD BE FOLDED TO 210 x 297 IN SUCH A WAY THAT THE TITLE BLOCK AND AUXILIARY NUMBER WILL ALWAYS APPEAR ON THE FRONT FACE, AND THE LAST FOLD WILL ALWAYS BE AT THE TOP. IN FILING, THIS PREVENTS OTHER DRAWINGS FROM BEING PUSHED IN THE FOLDS OF FILED PRINTS.
2. METHODS OF FOLDING PRINTS AS ILLUSTRATED PRINTS LARGER THAN A2 ARE FOLDED IN VERTICAL FOLDS ON 297 CENTRES THEN FOLDED AT 420 FROM THE LOWER EDGE.
3. ON PREPRINTED FORMS LARGER THAN SIZE A2 IT IS RECOMMENDED THAT FOLD MARKS FOR THE FIRST VERTICAL AND HORIZONTAL FOLDS BE INCLUDED IN THE MARGIN, AND IDENTIFIED BY NUMBER, FOR EXAMPLE, 'FOLD 1', 'FOLD 3'. IN ZONED PRINTS THE FOLD LINES WILL COINCIDE WITH ZONE BOUNDARIES BUT SHOULD NEVERTHELESS BE IDENTIFIED.
4. TO AVOID LOSS OF CLARITY BY FREQUENT FOLDING, IMPORTANT DETAILS SHOULD NOT BE PLACED IN CLOSE PROXIMITY TO FOLD.
5. DIMENSIONS ARE IN MILLIMETRES.

HALIFAX


DRAWING STANDARDS

**FOLDING OF
PAPER PRINTS**

| | | | |
|--------|------|-----------|--------------|
| DATE: | 2021 | REFERENCE | APPROVED |
| SCALE: | NTS | | FIG No.: |
| | | | DS 03 |

REVIEWED AND APPROVED FOR TRAFFIC SIGNALS AND PAVEMENT MARKINGS

Appr'd _____ Date _____
for TRAFFIC AUTHORITY

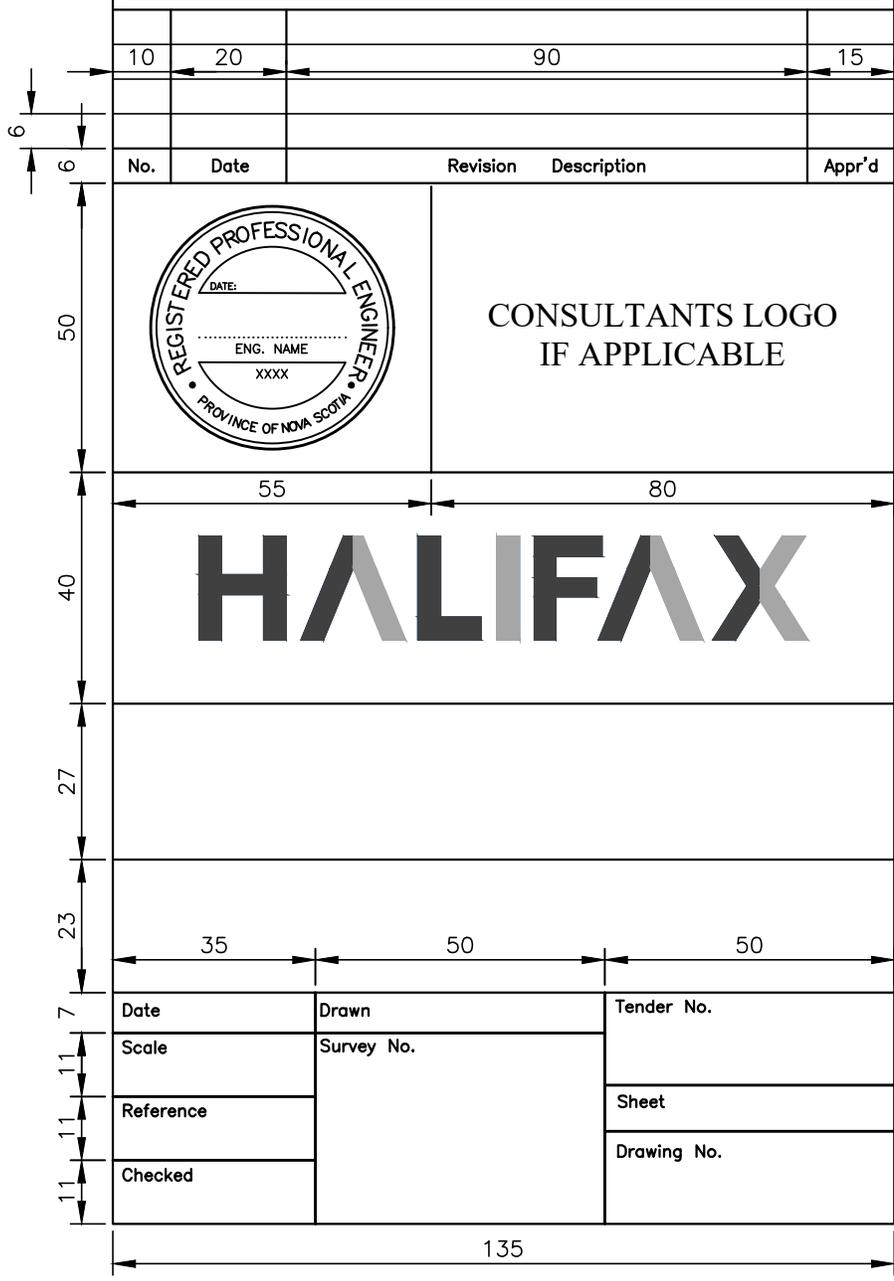

NOTES:

1. TITLE BLOCK FOR SHEETS A1 AND A1+.
2. DIMENSIONS ARE IN METRES.

HALIFAX

DRAWING STANDARDS

**TITLE BLOCK – TYPE I
SHOWING BLOCK DIMENSIONS**

| | | |
|--------|-----------|----------|
| DATE: | REFERENCE | APPROVED |
| 2021 | | |
| SCALE: | | FIG No.: |
| NTS | | DS 04 |

L=WIDTH 0.53 H=3.0

L=WIDTH 0.30 H=2.0

L=WIDTH 0.53 H=3.5

L=WIDTH 0.30 H=2.0

L=WIDTH 0.53 H=3.5

L=WIDTH 0.30 H=2.0

L=WIDTH 0.30 H=2.0

L=WIDTH 0.53 H=3.5

L=WIDTH 0.30 H=2.0

| | | | | | |
|--|---|-------------------------------------|-----------------------------------|--------|--|
| KEY PLAN | | | | | |
| SCALE 1:10 000 | | | | | |
| PLAN LEGEND | | | | | |
| NOTES | | | | | |
| REVIEWED AND APPROVED FOR TRAFFIC SIGNALS AND PAVEMENT MARKINGS | | | | | |
| Appr'd _____ Date _____ for TRAFFIC AUTHORITY | | | | | |
| 3 | | ISSUED FOR CONSTRUCTION | | | |
| 2 | | ISSUED FOR TENDER | | | |
| 1 | MON DY/YR | ISSUED FOR PRE-TENDER DESIGN REVIEW | | | |
| No. | Date | Revision | Description | Appr'd | |
|  | | | CONSULTANTS LOGO IF APPLICABLE | | |
| <h1 style="margin: 0;">HALIFAX</h1> | | | | | |
| STREET NAME | | | | | |
| LIMITS | | | | | |
| COMMUNITY | | | | | |
| SCOPE OF WORK | | | | | |
| Date XXXXX | Drawn xx | Tender No. 21-000 | | | |
| Scale Horz. 1:500 Vert. 1:50 | Survey No. SU18xxxx | Sheet 1 OF 1 | | | |
| Reference | DATUM HORZ: NAD83(CSR5) EPOCH 2010.0 3" MTM PROJECTION ZONE 5 | | Drawing No. 20000000 | | |
| Checked | VERT: CGVD2013 | | | | |

L=WIDTH 0.80 H=5.0

L=WIDTH 0.53 H=3.0

L=WIDTH 0.53 H=3.0

L=WIDTH 0.65 H=4.5

L=WIDTH 0.65 H=4.5

NOTES:

H=HEIGHT
L=LAYER


1. ALL TEXT TO BE OF THE STYLE "ROMANS" EXCEPT WHERE NOTED.
2. TITLE BLOCK FOR SHEETS A1 AND A1+.

HALIFAX

DRAWING STANDARDS

TITLE BLOCK - TYPE I SHOWING LAYER, HEIGHT AND STYLE

| | | | |
|--------|------|-----------|----------|
| DATE: | 2021 | REFERENCE | APPROVED |
| SCALE: | NTS | FIG No.: | DS 05 |

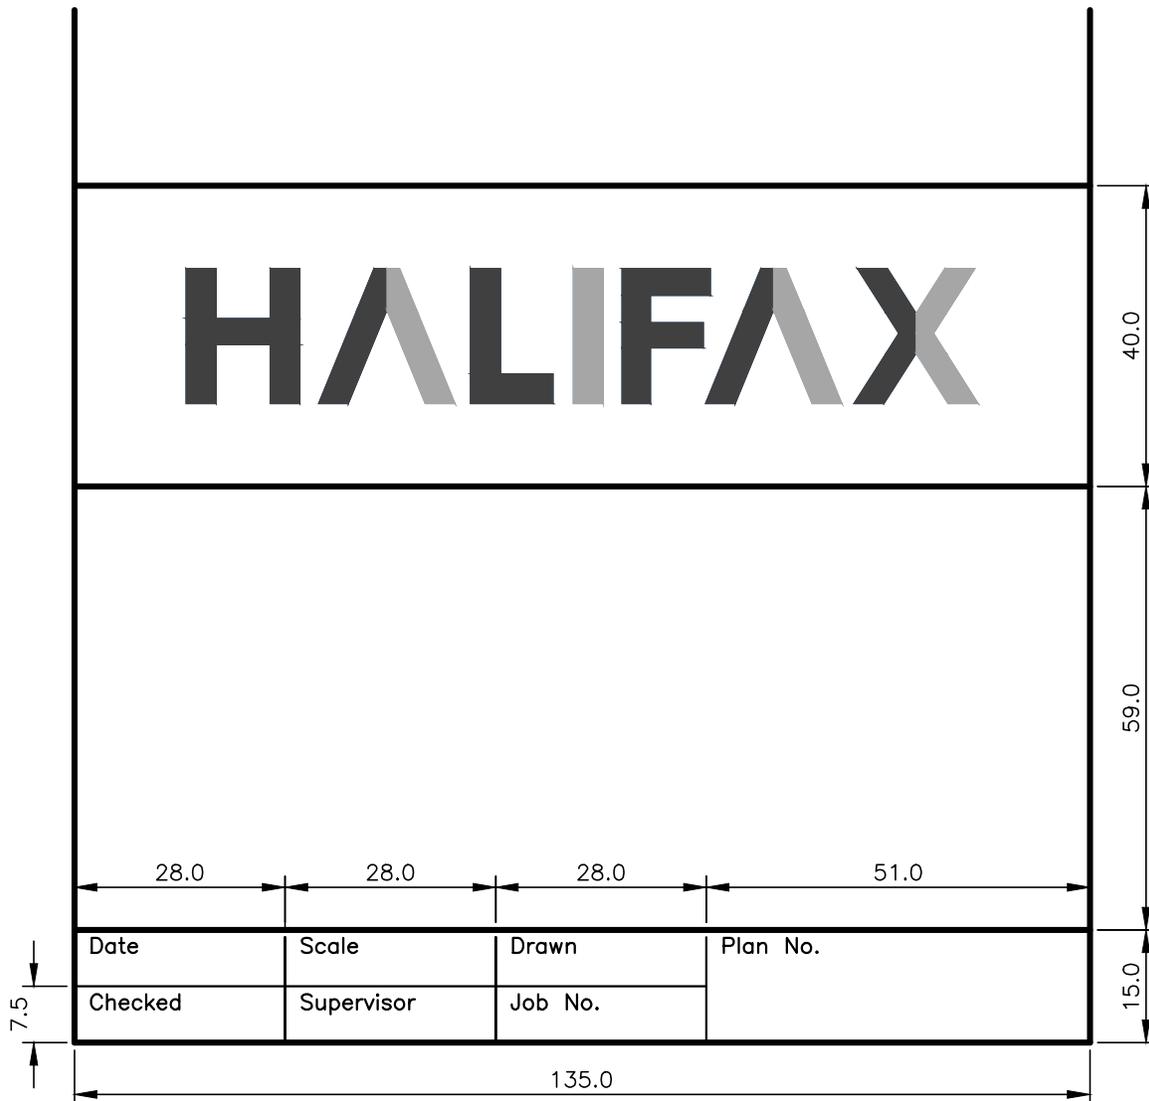

NOTES:

1. TITLE BLOCK FOR SHEET SIZE A2.
2. DIMENSIONS ARE IN METRES.

| | | |
|---|-----------|----------|
| HALIFAX | | |
| DRAWING STANDARDS | | |
| TITLE BLOCK LEGAL PLANS SHOWING BLOCK DIMENSIONS | | |
| DATE: | REFERENCE | APPROVED |
| 2021 | | |
| SCALE: | | FIG No.: |
| NTS | | DS 06 |

L=WIDTH 0.53 H=3.0

L=WIDTH 0.30 H=2.0

L=WIDTH 0.53 H=3.5

L=WIDTH 0.30 H=2.0

L=WIDTH 0.53 H=3.5

L=WIDTH 0.30 H=2.0

L=WIDTH 0.30 H=2.0

L=WIDTH 0.53 H=3.5

L=WIDTH 0.30 H=2.0

| | | | | | |
|--|---|-------------------------------------|-----------------------------------|-------------------------|--|
| KEY PLAN | | | | | |
| SCALE 1:10 000 | | | | | |
| PLAN LEGEND | | | | | |
| NOTES | | | | | |
| REVIEWED AND APPROVED FOR TRAFFIC SIGNALS AND PAVEMENT MARKINGS | | | | | |
| Appr'd _____ Date _____ for TRAFFIC AUTHORITY | | | | | |
| 3 | ISSUED FOR CONSTRUCTION | | | | |
| 2 | ISSUED FOR TENDER | | | | |
| 1 | MON DY/YR | ISSUED FOR PRE-TENDER DESIGN REVIEW | | | |
| No. | Date | Revision | Description | Appr'd | |
|  | | | CONSULTANTS LOGO IF APPLICABLE | | |
| DEVELOPERS LOGO | | | | | |
| STREET NAME LIMITS COMMUNITY | | | | | |
| SCOPE OF WORK | | | | | |
| Date | XXXXX | Drawn | xx | Tender No. | |
| Scale | Horz. 1:500 Vert. 1:50 | Survey No. | SU18xxxx | 21-000 | |
| Reference | DATUM HORZ: NAD83(CSRs) EPOCH 2010.0 3" MTM PROJECTION ZONE 5 VERT: CGVD2013 | | | Sheet 1 OF 1 | |
| Checked | | | | Drawing No. 20000000 | |

L=WIDTH 0.80 H=5.0

L=WIDTH 0.53 H=3.0

L=WIDTH 0.53 H=3.0

L=WIDTH 0.65 H=4.5

L=WIDTH 0.65 H=4.5

NOTES:

H=HEIGHT
L=LAYER

1. ALL TEXT TO BE OF THE STYLE "ROMANS" EXCEPT WHERE NOTED.
2. TITLE BLOCK FOR SHEETS A1 AND A1+.

HALIFAX

DRAWING STANDARDS

**TITLE BLOCK FOR DEVELOPERS
USED FOR SUBDIVISIONS
SHOWING LAYER, HEIGHT AND STYLE**

| | | |
|---------------|-----------|-------------------|
| DATE: 2021 | REFERENCE | APPROVED |
| SCALE: NTS | | FIG No.: DS 07 |

L=WIDTH 0.53
H=3.5

KEY PLAN

L=WIDTH 0.3
H=2.0

SCALE 1:10 000

L=WIDTH 0.53
H=3.5

LEGEND

L=WIDTH 0.3
H=2.0

L=WIDTH 0.53
H=3.5

NOTES

L=WIDTH 0.3
H=2.0

HALIFAX

PLAN OF SURVEY OF
LOT ??

L=WIDTH 0.8
H=5.0

SUBDISION OF

L=WIDTH 0.53
H=3.5

PARCEL ??

L=WIDTH 0.65
H=4.0

HALIFAX REGIONAL MUNICIPALITY

??????? AVENUE

L=WIDTH 0.53
H=3.0

HALIFAX

HALIFAX COUNTY

NOVA SCOTIA

L=WIDTH 0.3
H=2.0

| | | | |
|---------|-----------------|---------------------|------------|
| Date | Scale XXXXXX | Drawn XX | Plan No. |
| Checked | Supervisor | Job No. SU000XXX | XXXXXXXXXX |

L=WIDTH 0.3
H=2.5

L=WIDTH 0.3
H=2.0

L=WIDTH 0.53
H=3.0

L=WIDTH 0.53
H=3.0

L=WIDTH 0.53
H=3.0

L=WIDTH 0.53
H=3.0

L=WIDTH 0.65
H=5.0

NOTE:

ALL TEXT TO BE OF THE STYLE "ROMANS".

L = LAYER
H = HEIGHT


HALIFAX

DRAWING STANDARDS

TITLE BLOCK LEGAL PLANS
SHOWING TEXT HEIGHTS

| | | | |
|--------|------|-----------|-------------------|
| DATE: | 2021 | REFERENCE | APPROVED |
| SCALE: | NTS | | FIG No.: DS 08 |

HALIFAX

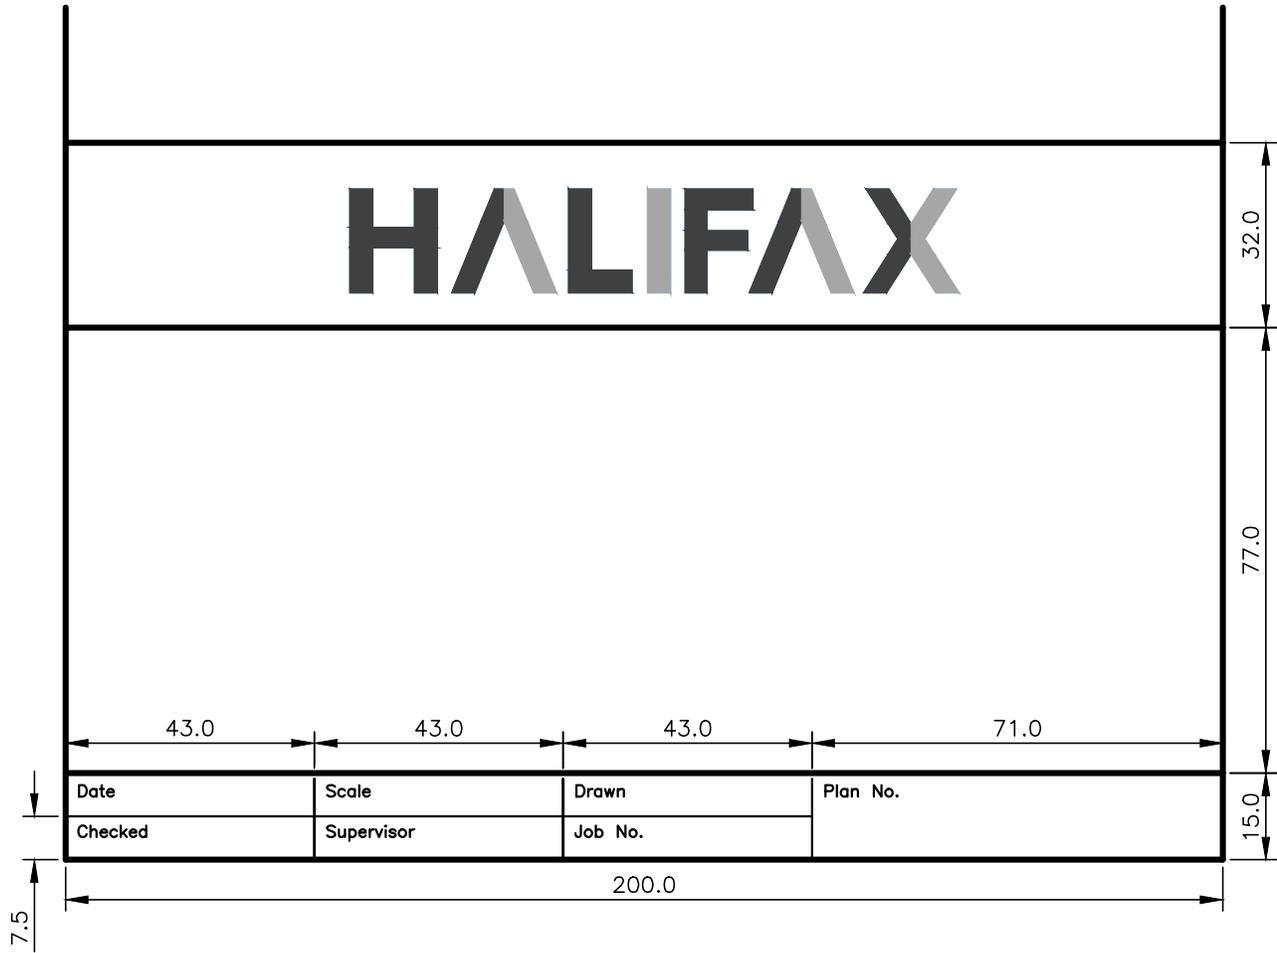

NOTES:

1. TITLE BLOCK FOR SHEET SIZES A1 AND A0.
2. DIMENSIONS ARE IN METRES.

HALIFAX

DRAWING STANDARDS

**TITLE BLOCK LEGAL PLANS
SHOWING BLOCK DIMENSIONS**

| | | | |
|--------|------|-----------|--------------------------|
| DATE: | 2021 | REFERENCE | APPROVED |
| SCALE: | NTS | | FIG No.: DS 09 |

HALIFAX REGIONAL MUNICIPALITY SYMBOLS

| BLOCK NAME | SYMBOL | DESCRIPTION |
|------------|--------|------------------------------------|
| SWMHCO | | COMBINED MANHOLE |
| PLSWMHCO | | PROPOSED COMBINED MANHOLE |
| SWMHST | | STORM MANHOLE |
| PLSWMHST | | PROPOSED STORM MANHOLE |
| SWMHSA | | SANITARY MANHOLE |
| PLSWMHSA | | PROPOSED SANITARY MANHOLE |
| SWCB | | CATCHBASIN |
| PLSWCB | | PROPOSED CATCHBASIN |
| SWCBDB | | DOUBLE CATCHBASIN |
| PLSWCBDB | | PROPOSED DOUBLE CATCHBASIN |
| SWPS | | PUMPING STATION |
| PLSWPS | | PROPOSED PUMPING STATION |
| SWMHUK | | UNKNOWN MANHOLE |
| UTMHTL | | ALIAN T MANHOLE |
| UTMHPW | | N.S. POWER MANHOLE OR JUNCTION BOX |
| WCHY | | HRWC FIRE HYDRANT |
| PLWCHY | | PROPOSED HRWC FIRE HYDRANT |
| WCVL | | HRWC WATER VALVE |
| PLWCVL | | PROPOSED HRWC WATER VALVE |
| UTPO | | UTILITY POLE |
| PLUTPO | | PROPOSED UTILITY POLE |
| TFTL | | TRAFFIC LIGHT STANDARD |
| PLTFTL | | PROPOSED TRAFFIC LIGHT STANDARD |
| TFSL | | STREET LIGHT STANDARD |
| PLTFSL | | PROPOSED STREET LIGHT STANDARD |
| TFSP | | SIGN POST |
| PLTFSP | | PROPOSED SIGN POST |
| LCTS | | TREE |
| PLLCTS | | PROPOSED TREE |
| LCSA | | SHRUB |
| MNNSCM | | NOVA SCOTIA COORDINATE MONUMENT |
| PLTFPR | | PROPOSED PEDESTRIAN RAMP |
| TFPR | | PEDESTRIAN RAMP |
| TFPM | | PARKING PAY STATION |
| UTGW | | GUY WIRE ANCHOR |
| TRBS | | BUS STOP |
| SVIB | | IRON BAR |
| SVIP | | IRON PIPE |
| SVDH | | DRILL HOLE |
| SVRS | | RAILWAY SPIKE |
| SVSM | | SURVEY MARKER |
| SVRP | | ROCK POST |
| SVNL | | NAIL |
| TFJB | | TRAFFIC LOOP JUNCTION BOX |
| TFCB | | TRAFFIC CABINET OR CONTROLLER BOX |
| SWIN | | SEWER INLET |
| SWOF | | SEWER OUTFALL |
| WCCHMH | | HRWC MAHNOLE |
| GSVL | | GAS VALVE |
| TFRS | | PROPOSED RADAR SYSTEM |
| TFSH | | TRAFFIC SIGNAL HEAD |
| TFPH | | PEDESTRIAN HEAD |
| PLTFSH | | PROPOSED TRAFFIC SIGNAL HEAD |
| PLTFPH | | PROPOSED PEDESTRIAN HEAD |
| CNLM | | LIMIT OF CONSTRUCTION |

NOTE: ALL SYMBOLS ON LAYER HE--SYMBOLS--ALL



HALIFAX

DRAWING STANDARDS

STANDARD DRAWING SYMBOLS PLAN

| | | |
|--------|-----------|----------|
| DATE: | REFERENCE | APPROVED |
| 2021 | | |
| SCALE: | | FIG No.: |
| NTS | | DS 10 |

HALIFAX REGIONAL MUNICIPALITY SYMBOLS

| <u>BLOCK NAME</u> | <u>SYMBOL</u> | <u>DESCRIPTION</u> |
|-------------------|---------------|-----------------------------------|
| TFMKAR3T | | TRAFFIC ARROW RIGHT-STRAIGHT-LEFT |
| TFMKARLT | | LEFT TURN ARROW |
| TFMKARRT | | RIGHT TURN ARROW |
| TFMKARTL | | TRAFFIC ARROW STRAIGHT-LEFT |
| TFMKARTR | | TRAFFIC ARROW STRAIGHT-RIGHT |
| TFMKARST | | TRAFFIC ARROW STRAIGHT |
| TFMKARRLT | | TRAFFIC ARROW LEFT-RIGHT |

* NOTE: ALL SYMBOLS ON LAYER HE-SYMBOLS-ALL

DEPRESSION

CUT

FILL

TRAIL

STREAM

CONTOURS

+N 4 945 783.000 COORDINATES
E 5 565 324.000

POWER TRANSMISSION TOWER

WELL

TREED AREA OR BUSH

SWAMP AREA

56.75 SPOT ELEVATION

GASOLINE PUMPS WITH ISLAND

CULVERT (STATE TYPE, ID. & LENGTH)

PROPOSED CONCRETE SURFACE

PROPOSED ASPHALT SURFACE

HALIFAX

DRAWING STANDARDS

**STANDARD DRAWING
SYMBOLS PLAN**

| | | | |
|--------|------|-----------|--------------------------|
| DATE: | 2021 | REFERENCE | APPROVED |
| SCALE: | NTS | | FIG No.: DS 11 |


CONTROL VALUES – SUXXXXX
 COORDINATE VALUES – NAD83(CSRS) EPOCH 2010.0
 3° MTM PROJECTION ZONE 5, VERTICAL CGVD2013

| PT. NO. | NORTHING | EASTING | ELEVATION | DESCRIPTION |
|---------|---------------|----------------|-----------|-------------|
| 1 | 4 958 712.713 | 25 563 994.063 | 50.878 | DRILL HOLE |
| 2 | 4 958 760.369 | 25 564 037.398 | 49.632 | DRILL HOLE |
| 3 | 4 958 793.231 | 25 563 989.019 | 53.447 | SPIKE |
| 222185 | 4 958 867.433 | 25 563 264.290 | 64.472 | NSCM-MEAS. |
| 223681 | 4 958 203.467 | 25 565 530.677 | 27.623 | NSHPN-PUB. |

VALUES SHOWN ARE BASED ON THE NOVA SCOTIA COORDINATE REFERENCING SYSTEM. PLAN DETAILS ARE REFERRED TO THE CONTROL TABLE ABOVE. BOUNDARY LINES ARE APPROXIMATE, AND ARE SUBJECT TO A FIELD SURVEY.

STREET NAME CENTRELINE ALIGNMENT

| ID # | STATION | RADIUS | NORTHING | EASTING | DEF ANGLE |
|------|----------------------------|--------|------------------|--------------------|-------------|
| L1 | 0+000.00 0+028.12 | | -0.662 19.077 | 24.297 44.320 | |
| C1 | BC 0+028.12 EC 0+067.03 | 50.000 | 19.077 33.471 | 44.320 79.423 | 44° 35' 30" |
| L2 | 0+067.03 0+131.61 | | 33.471 33.471 | 79.423 144.003 | |
| C2 | BC 0+131.61 EC 0+165.90 | 70.000 | 33.471 25.238 | 144.003 176.940 | 28° 04' 07" |
| L3 | 0+165.90 0+190.00 | | 25.238 13.900 | 176.940 198.202 | |

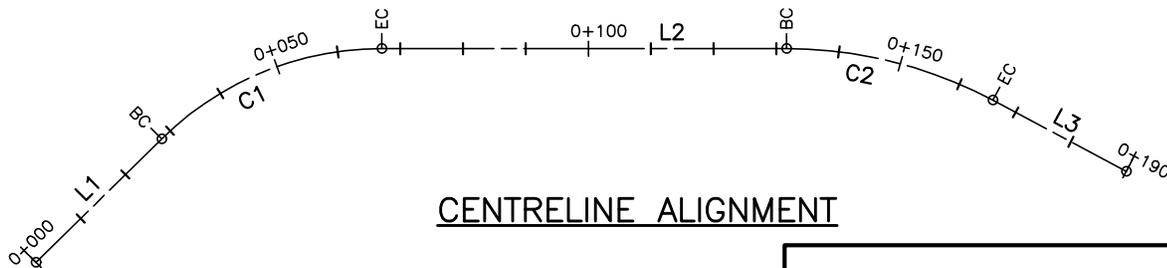

HALIFAX

DRAWING STANDARDS

**CONTROL TABLES
 (SHOWING INFORMATION
 FOR PROJECT LAYOUT)**

| | | | |
|--------|------|-----------|-------------------|
| DATE: | 2021 | REFERENCE | APPROVED |
| SCALE: | NTS | | FIG No.: DS 12 |

| IDENTIFICATION | MATERIAL | ITEM | SIZE/WIDTH | COLOUR | QUANTITY |
|----------------|----------|--|---|--------|-----------------|
| P1.1 | PAINT | SINGLE LINE-SOLID | 100 mm | WHITE | #m |
| P1.2 | PAINT | SINGLE LINE-BROKEN | 100 mm (3 m LINE, 6 m SPACING) | WHITE | #m |
| P1.3 | PAINT | SINGLE LINE-BROKEN | 100 mm (3 m LINE, 3 m SPACING) | WHITE | #m |
| P1.4 | PAINT | SINGLE LINE-BROKEN | 100 mm (1.8 m LINE, 1.8 m SPACING) | WHITE | #m |
| P1.5 | PAINT | SINGLE LINE-BROKEN | 100 mm (1.5 m LINE, 1.5 m SPACING) | WHITE | #m |
| P1.6 | PAINT | SINGLE LINE-BROKEN | 100 mm (1.0 m LINE, 1.0 m SPACING) | WHITE | #m |
| P1.7 | PAINT | SINGLE LINE-BROKEN | 100 mm (0.5 m LINE, 0.5 m SPACING) | WHITE | #m |
| P1.10 | PAINT | SINGLE LINE-SOLID | 100 mm | YELLOW | #m |
| P1.11 | PAINT | SINGLE LINE-BROKEN | 100 mm (3 m LINE, 6 m SPACING) | YELLOW | #m |
| P1.12 | PAINT | DOUBLE CENTRELINE-SOLID | 100 mm | YELLOW | #m |
| P1.13 | PAINT | DOUBLE CENTRELINE- SINGLE SOLID w SINGLE BROKEN | 100 mm (3 m LINE, 6 m SPACING) | YELLOW | #m |
| P1.14 | PAINT | DOUBLE LINE-BROKEN | 100 mm (3 m LINE, 6 m SPACING) | YELLOW | #m |
| P2 | PAINT | STOP BAR | 450 mm | WHITE | #m |
| P3 | PAINT | YIELD LINE | 450 mm WIDE, SPACING VARIES, SEE HRM STANDARD DETAIL 90 | WHITE | #m |
| P4 | PAINT | CROSSWALK | 2 x 200 mm | WHITE | #m |
| P5 | PAINT | ZEBRA CROSSWALK | 600 mm WIDE, 600 mm SPACING, 2.5 m WIDE | WHITE | #m |
| P6 | PAINT | HATCHING | 100 mm LANE LINES, 450 mm HATCH LINES, 6.0 m SPACING | WHITE | #m ² |
| P7 | PAINT | HATCHING | 100 mm LANE LINES, 450 mm HATCH LINES, 6.0 m SPACING | YELLOW | #m ² |
| P8 | PAINT | INTERSECTION BOX w HATCHING | 200 mm LINES, 1.2 m SPACING | WHITE | #m ² |
| P9.1 | PAINT | ARROW | 3/4 TAC SIZE | WHITE | #EA. |
| P9.2 | PAINT | ARROW | 1/2 TAC SIZE | WHITE | #EA. |
| P9.3 | PAINT | ROUNDBOUT ARROW | SEE HRM STANDARD DETAIL 95 | WHITE | #EA. |
| P10 | PAINT | BICYCLE SYMBOL | 1.2 m X 2.1 m | WHITE | #EA. |
| P11 | PAINT | ADVANCE YIELD TO PEDESTRIANS LINE (TRIANGLES) | SEE HRM STANDARD DETAIL 93 | WHITE | #m |
| P12 | PAINT | SPEED HUMP/SPEED TABLE MARKINGS | SEE HRM STANDARD DETAIL 31 & 143 | WHITE | # SITES |
| P13 | PAINT | RESERVED LANE DIAMOND SYMBOL | 0.75 m X 3.0 m | WHITE | #EA. |
| P15.1 | PAINT | SHARED USE LANE SYMBOL | 1.2 m X 3.0 m | WHITE | #EA. |
| P30 | PAINT | NEW INTERSECTION MARKINGS | - | - | LS |
| P31 | PAINT | REMOVAL OF EXISTING MARKINGS | - | - | LS |
| P32 | PAINT | REPLACEMENT OF EXIST. MARKINGS | - | - | LS |

HALIFAX

DRAWING STANDARDS PAVEMENT MARKING TABLE (PAINT)

| | | | |
|--------|------|-----------|---------------------|
| DATE: | 2021 | REFERENCE | APPROVED |
| SCALE: | NTS | | FIG No.: DS 13.1 |

| IDENTIFICATION | MATERIAL | ITEM | SIZE/WIDTH | COLOUR | QUANTITY |
|----------------|---------------|---|--|---------------------------------|-----------------|
| T1.1 | THERMOPLASTIC | SINGLE LINE-SOLID | 100 mm | WHITE | #m |
| T1.2 | THERMOPLASTIC | SINGLE LINE-BROKEN | 100 mm (3 m LINE, 6 m SPACING) | WHITE | #m |
| T1.3 | THERMOPLASTIC | SINGLE LINE-BROKEN | 100 mm (3 m LINE, 3 m SPACING) | WHITE | #m |
| T1.4 | THERMOPLASTIC | SINGLE LINE-BROKEN | 100 mm (1.8 m LINE, 1.8 m SPACING) | WHITE | #m |
| T1.5 | THERMOPLASTIC | SINGLE LINE-BROKEN | 100 mm (1.5 m LINE, 1.5 m SPACING) | WHITE | #m |
| T1.6 | THERMOPLASTIC | SINGLE LINE-BROKEN | 100 mm (1.0 m LINE, 1.0 m SPACING) | WHITE | #m |
| T1.7 | THERMOPLASTIC | SINGLE LINE-BROKEN | 100 mm (0.5 m LINE, 0.5 m SPACING) | WHITE | #m |
| T1.10 | THERMOPLASTIC | SINGLE LINE-SOLID | 100 mm | YELLOW | #m |
| T1.11 | THERMOPLASTIC | SINGLE LINE-BROKEN | 100 mm (3 m LINE, 6 m SPACING) | YELLOW | #m |
| T1.12 | THERMOPLASTIC | DOUBLE CENTRELINE-SOLID | 100 mm | YELLOW | #m |
| T1.13 | THERMOPLASTIC | DOUBLE CENTRELINE-SINGLE SOLID w SINGLE BROKEN | 100 mm (3 m LINE, 6 m SPACING) | YELLOW | #m |
| T1.14 | THERMOPLASTIC | DOUBLE LINE-BROKEN | 100 mm (3 m LINE, 6 m SPACING) | YELLOW | #m |
| T2 | THERMOPLASTIC | STOP BAR | 450 mm | WHITE | #m |
| T3 | THERMOPLASTIC | YIELD LINE | 450 mm | WHITE | #m |
| T4 | THERMOPLASTIC | CROSSWALK | 2 x 200 mm | WHITE | #m |
| T5 | THERMOPLASTIC | ZEBRA CROSSWALK | 600 mm | WHITE | #m |
| T6 | THERMOPLASTIC | HATCHING | 100 mm LANE LINES, 450 mm HATCH LINES, 6.0 m SPACING | WHITE | #m ² |
| T7 | THERMOPLASTIC | HATCHING | 100 mm LANE LINES, 450 mm HATCH LINES, 6.0 m SPACING | YELLOW | #m ² |
| T8 | THERMOPLASTIC | INTERSECTION BOX w HATCHING | 200 mm LINES, 1.2 m SPACING | WHITE | #m ² |
| T9.1 | THERMOPLASTIC | ARROW | 3/4 TAC SIZE | WHITE | #EA. |
| T9.2 | THERMOPLASTIC | ARROW | 1/2 TAC SIZE | WHITE | #EA. |
| T9.3 | THERMOPLASTIC | ROUNDBOUT ARROW | SEE HRM STANDARD DETAIL 95 | WHITE | #EA. |
| T10.1 | THERMOPLASTIC | BICYCLE SYMBOL ON BLACK BACKGROUND | 1.2 m X 2.1 m | WHITE ON BLACK BACKGROUND | #EA. |
| T10.2 | THERMOPLASTIC | BICYCLE SYMBOL ON GREEN BACKGROUND | 1.2 m X 2.1 m | WHITE ON GREEN BACKGROUND | #EA. |
| T11 | THERMOPLASTIC | ADVANCE YIELD TO PEDESTRIANS LINE (TRIANGLES) | SEE HRM STANDARD DETAIL 93 | WHITE | #m |
| T12 | THERMOPLASTIC | SPEED HUMP/SPEED TABLE MARKINGS | SEE HRM STANDARD DETAIL 31 & 143 | WHITE | # SITES |
| T13 | THERMOPLASTIC | RESERVED LANE DIAMOND SYMBOL ON BLACK BACKGROUND | 0.75 m X 3.0 m | WHITE | #EA. |
| T14 | THERMOPLASTIC | RESERVED LANE DIAMOND SYMBOL ON RED BACKGROUND | 0.75 m X 3.0 m 2.8 m X 4.3 m | WHITE RED | #EA. |
| T15.1 | THERMOPLASTIC | SHARED USE LANE SYMBOL ON BLACK BACKGROUND | 1.2 m X 3.3 m | WHITE ON BLACK BACKGROUND | #EA. |
| T15.2 | THERMOPLASTIC | SHARED USE LANE SYMBOL ON GREEN BACKGROUND | 1.2 m X 3.3 m | WHITE ON GREEN BACKGROUND | #EA. |

| IDENTIFICATION | MATERIAL | ITEM | SIZE/WIDTH | COLOUR | QUANTITY |
|----------------|---------------|--|---|---------------------------------|-----------|
| T16 | THERMOPLASTIC | SHARKS TEETH TRIANGLES | 450 mm X 150 mm, 5 PER ROW | WHITE | # ROWS |
| T17 | THERMOPLASTIC | TWO STAGE BICYCLE LEFT TURN BOX | 2.0 m X 3.0 m | WHITE ON GREEN BACKGROUND | #EA. |
| T18 | THERMOPLASTIC | VEHICLE/BICYCLE ZEBRA CONFLICT MARKING (1.8 m X 0.6 m TOTAL) | 1.5 m X 0.6 m ADD. 0.15 m EA. END | GREEN WHITE | #EA. |
| T19 | THERMOPLASTIC | DRIVEWAY/BICYCLE ZEBRA CONFLICT MARKING (1.3 m X 0.6 m TOTAL) | 1.0 m X 0.6 m ADD. 0.15 m EA. END | GREEN WHITE | #EA. |
| T20 | THERMOPLASTIC | BICYCLE/PEDESTRIAN ZEBRA CONFLICT MARKING | 2.5 m X 0.3 m WIDE, 0.3 m SPACING | WHITE | #m |
| T21 | THERMOPLASTIC | TRAIL CROSSWALK | 200 mm SOLID LINE (2.5 m WIDTH) 200 mm BROKEN LINE 0.4 m LINE, 0.4m SPACING (4.5 m WIDTH) | WHITE | #m |
| T30 | THERMOPLASTIC | NEW INTERSECTION MARKINGS | - | - | LS |
| T31 | THERMOPLASTIC | REMOVAL OF EXISTING MARKINGS | - | - | LS |
| T32 | THERMOPLASTIC | REPLACEMENT OF EXIST. MARKINGS | - | - | LS |


HALIFAX

DRAWING STANDARDS

PAVEMENT MARKING TABLE (THERMOPLASTIC)

| | | | |
|--------|------|-----------|----------------------------|
| DATE: | 2021 | REFERENCE | APPROVED |
| SCALE: | NTS | | FIG No.: DS 13.2 |

ROBIE STREET

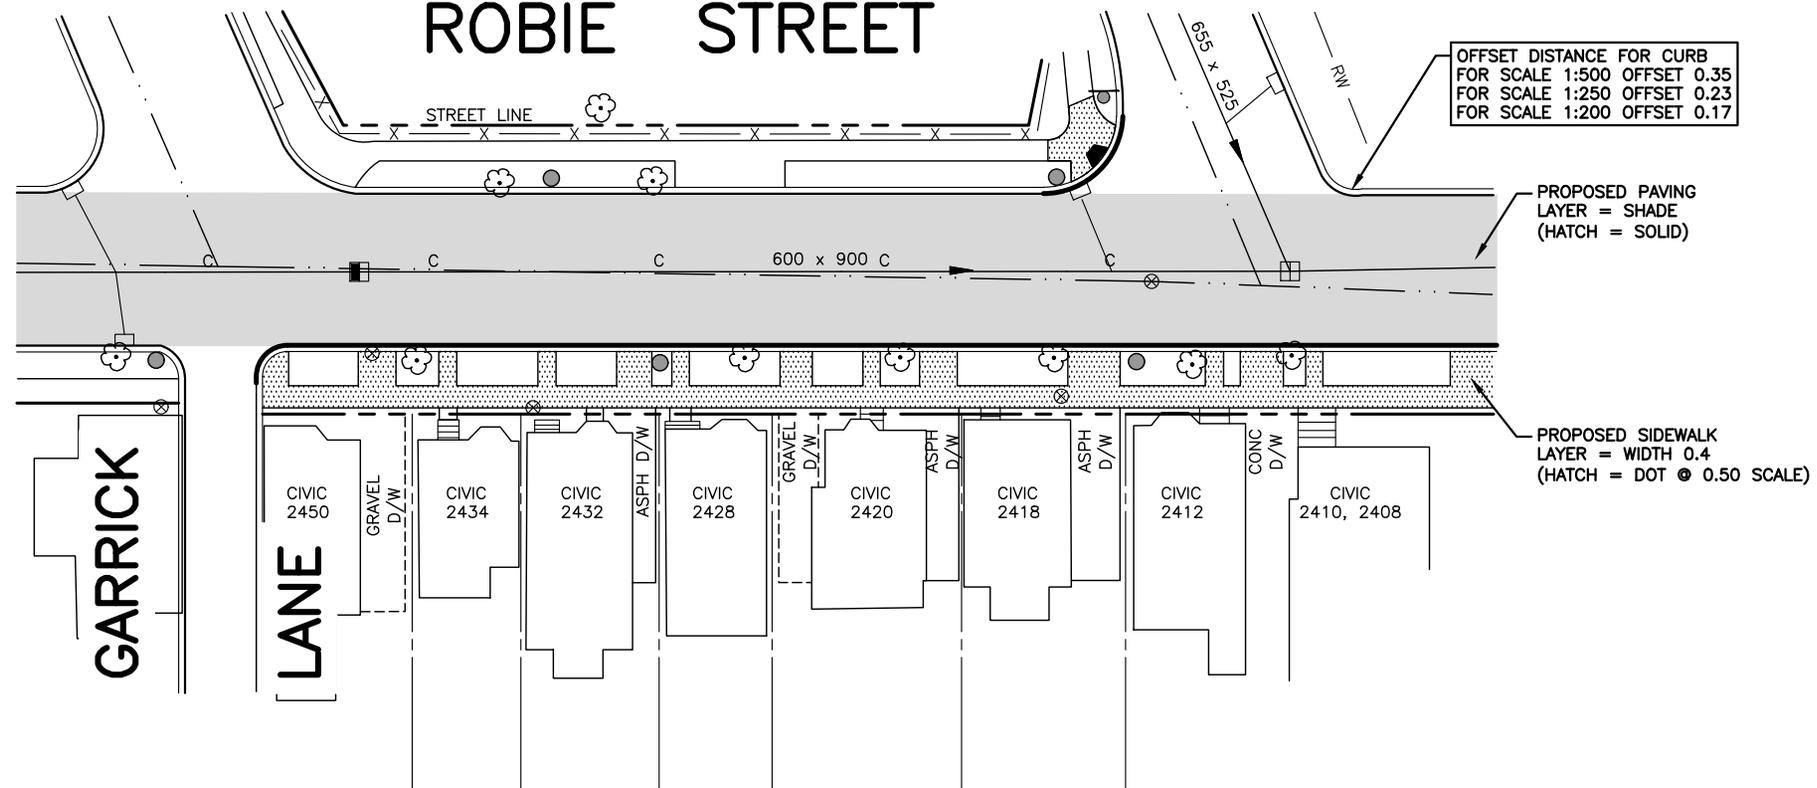


OFFSET DISTANCE FOR CURB
 FOR SCALE 1:500 OFFSET 0.35
 FOR SCALE 1:250 OFFSET 0.23
 FOR SCALE 1:200 OFFSET 0.17

PROPOSED PAVING
 LAYER = SHADE
 (HATCH = SOLID)

PROPOSED SIDEWALK
 LAYER = WIDTH 0.4
 (HATCH = DOT @ 0.50 SCALE)

DIMENSION STYLE OVERRIDES:

- DIMASZ 3.5000
- DIMCLRD 9
- DIMCLRE 9
- DIMCLRT 9
- DIMEXE 1.5000
- DIMEXO 1.5000
- DIMGAP 1.0000
- DIMSCALE 0.0000
- DIMTAD 1
- DIMTXSTY ROMANS
- DIMTXT 2.0000

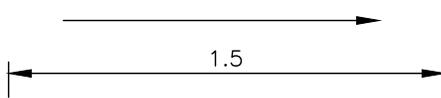


HALIFAX

DRAWING STANDARDS

PLAN HATCHING LAYERS AND LINETYPES

| | | | |
|--------|------|-----------|----------|
| DATE: | 2021 | REFERENCE | APPROVED |
| SCALE: | NTS | | FIG No.: |
| | | | DS 14 |

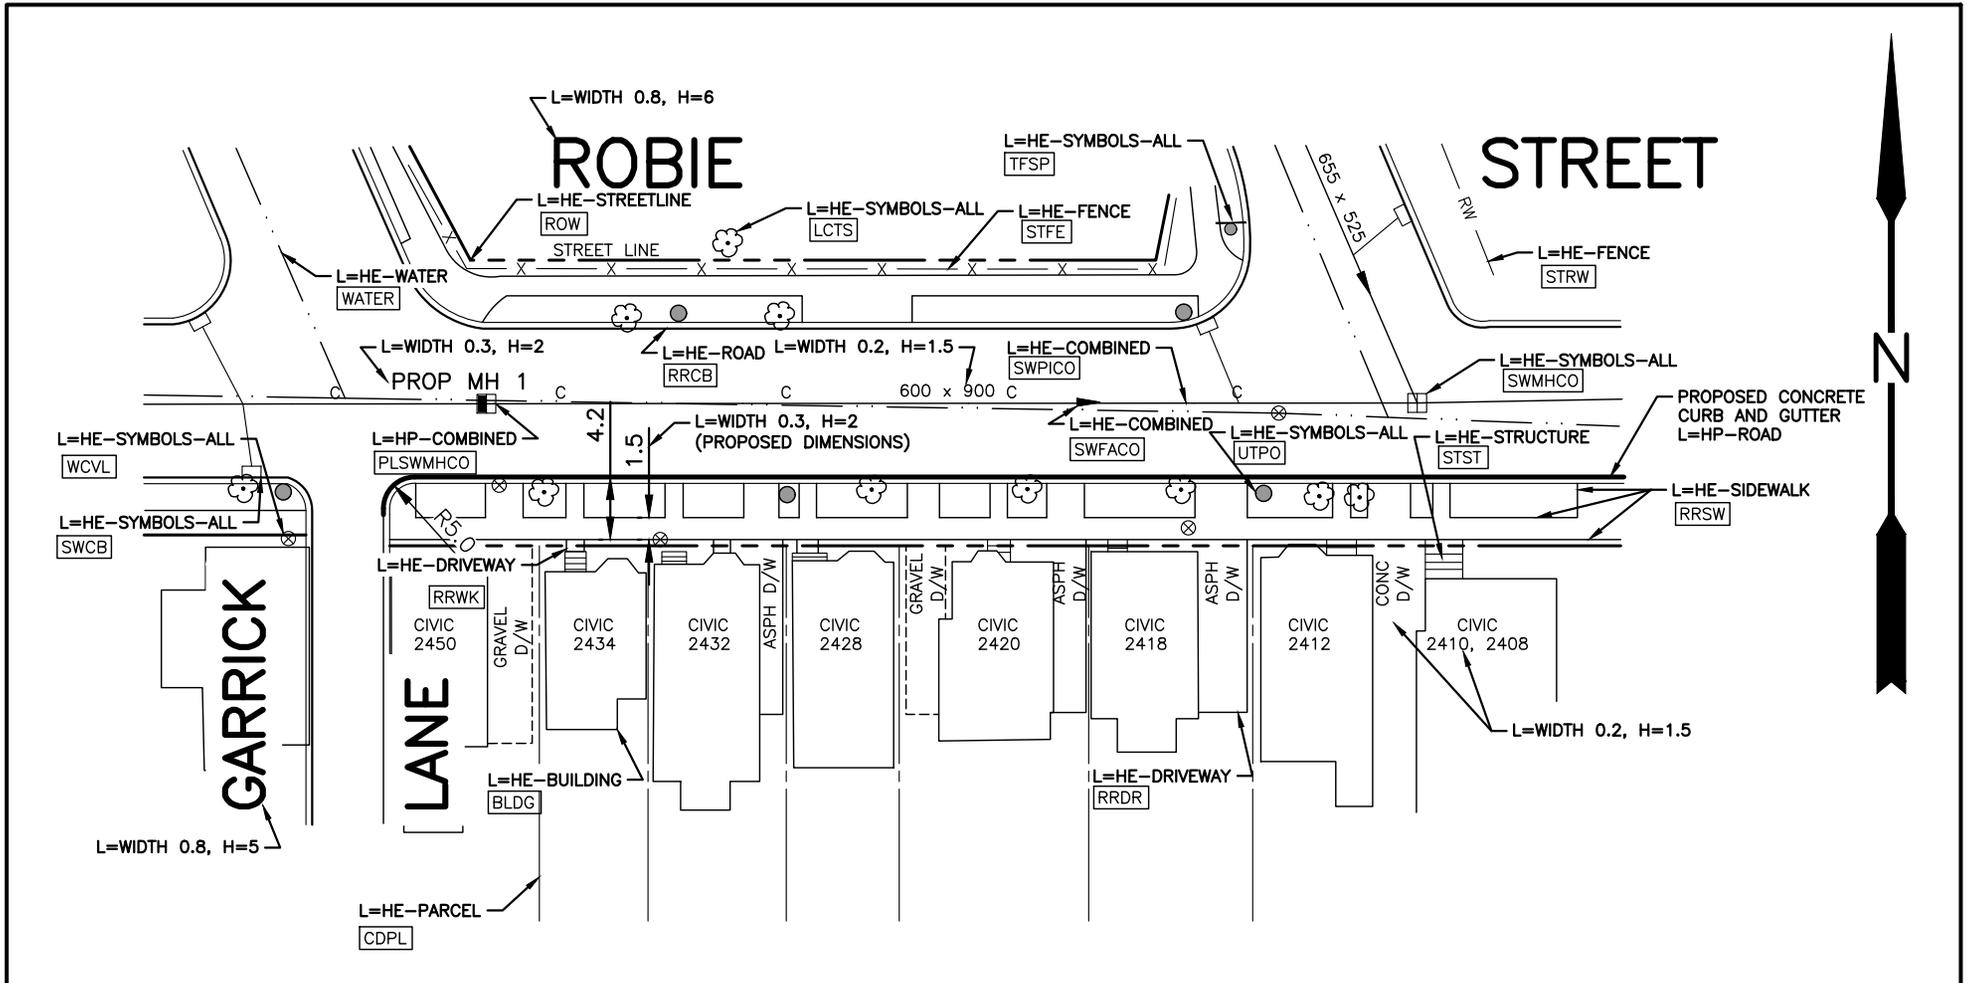

NOTE:

1. ALL TEXT WHICH PERTAINS TO PROPOSED INFORMATION SHALL BE A MINIMUM HEIGHT OF 2.0.


BLDG BLOCK NAMES OR LINETYPES
 L LAYER
 H HEIGHT

HALIFAX

DRAWING STANDARDS

PLAN TEXT SIZES LAYERS,
AND LINETYPES

| | | | |
|--------|------|-----------|--------------|
| DATE: | 2021 | REFERENCE | APPROVED |
| SCALE: | NTS | | FIG No.: |
| | | | DS 15 |

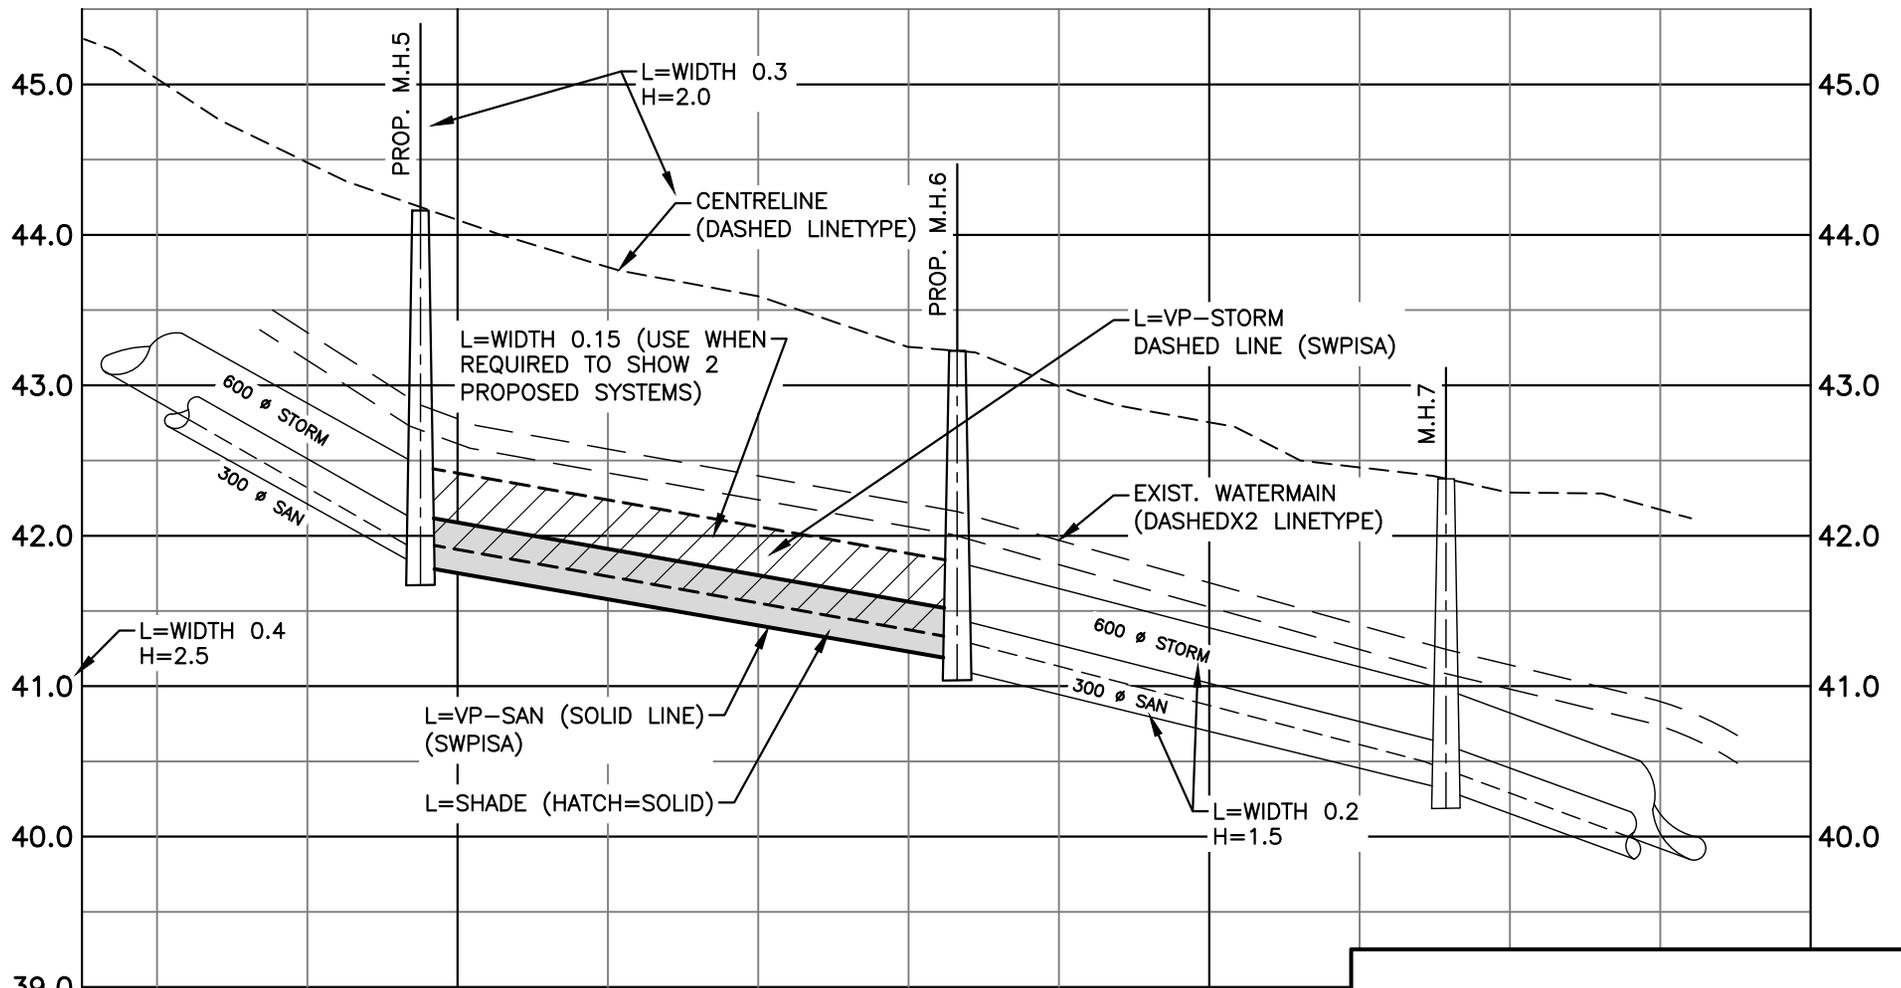

| | | | | |
|----------------|---------------------------------|--------|---------|-------|
| 0+075 | 0+097.0 | 0+100 | 0+133.0 | 0+150 |
| | 41.900 | 41.800 | 41.113 | |
| STORM SEWER | 36.0 ± - 300 Ø PVC SDR35 @ 4.8% | | | |
| | 41.900 | 41.800 | 41.113 | |
| SANITARY SEWER | 36.0 ± - 300 Ø CONC. @ 4.8% | | | |

L = LAYER
 H = HEIGHT


REQUIRED IF NOT USING CIVIL 3D

HALIFAX

DRAWING STANDARDS

PROFILE TEXT SIZES,
LAYERS AND LINETYPES

| | | | |
|--------|------|-----------|----------|
| DATE: | 2021 | REFERENCE | APPROVED |
| SCALE: | NTS | | FIG No.: |
| | | | DS 17 |

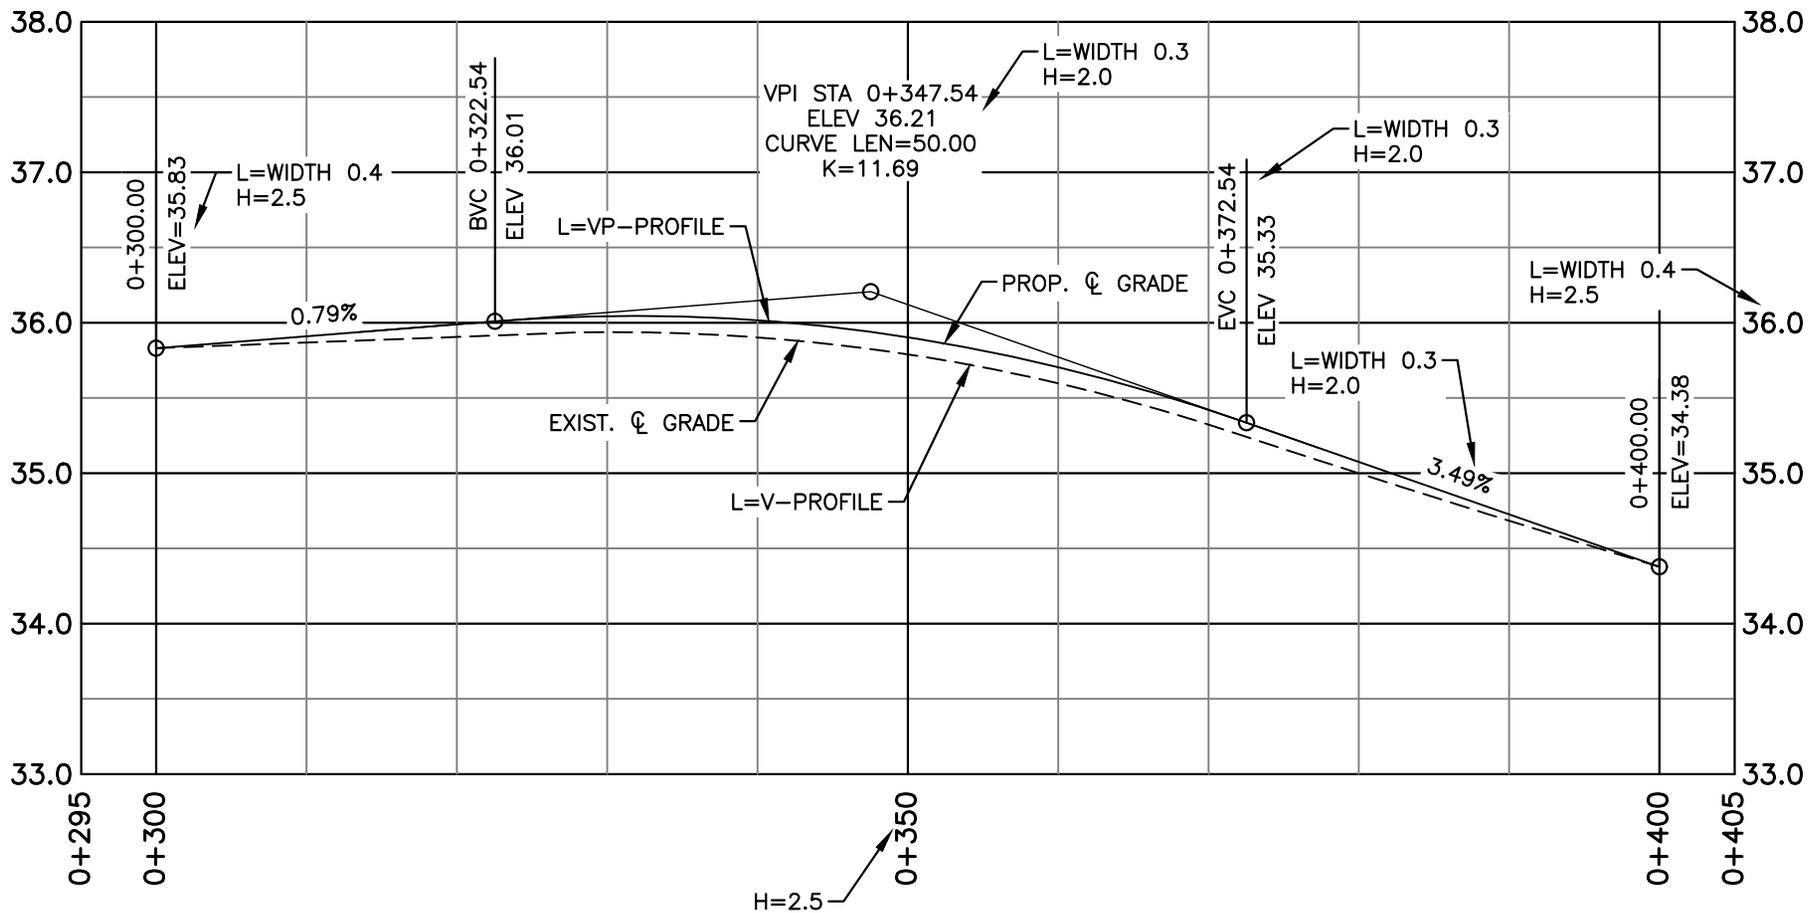

L = LAYER
H = HEIGHT

HALIFAX

DRAWING STANDARDS

PROFILE TEXT SIZES,
LAYERS AND LINETYPES




| | | | |
|--------|------|-----------|----------|
| DATE: | 2021 | REFERENCE | APPROVED |
| SCALE: | NTS | | FIG No.: |
| | | | DS 18 |

LINETYPES FOR LEGAL DRAWINGS

| <u>LABEL</u> | | <u>LINETYPE NAME</u> | <u>LAYER</u> |
|----------------------|---------------------------------------|---|-------------------------|
| TIE LINE | ----- | TIELINE | HE-PARCEL |
| RADIAL LINE | ----- | RADLINE | HE-PARCEL |
| CO TERMINAL BOUNDARY | PROPOSED ----- | PROPLINE | HE-PARCEL |
| | APPROVED ----- | CDPL | HE-PARCEL |
| RIGHT OF WAY | ----- | ROW | HE-PARCEL |
| EASEMENT | ----- | CDES | HE-PARCEL |
| SURVEYED BOUNDARY | ————— | CONTINUOUS | HE-SURVEY |
| DITCH | ----- | WADI | HE-HYDRO |
| WATERCOURSE | — · · — · · — · · — · · — · · — · · — | WATER | HE-HYDRO |
| SEWER | —————▶ | LINE SHOULD BE CONSISTENT WITH ENG. DWGS. | HE-SEWER |
| EDGE OF ASPHALT | ————— LABEL | CONTINUOUS | HE-ROAD/ HE-DRIVEWAY |
| EDGE OF D/W, ETC | | | |
| EDGE OF GRAVEL | ----- LABEL | RRWK-G | HE-ROAD/ HE-DRIVEWAY |
| EDGE OF D/W, ETC | | | |
| FENCE | — x — x — CHAIN-LINK FENCE — x — x — | STFE | HE-FENCE |
| HEDGE | — H — H — H — H — H — H — | LCHG | HE-TREE LINE |
| WALL | — W — W — W — W — W — W — | STWL | HE-FENCE |
| RETAINING WALL | — RW — RW — RW — RW — RW — | STRW | HE-STRUCTURE |

NOTE:

ANY LINETYPES THAT ARE DRAWN ON A LEGAL DRAWING, (EXAMPLE: SEWER, GUYWIRE, FENCE, RETAINING WALL ETC.) SHOULD BE CONSISTENT WITH ENGINEERING DRAWINGS. THAT ALSO APPLYS TO SYMBOLS.

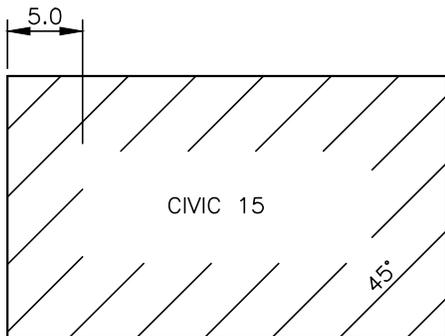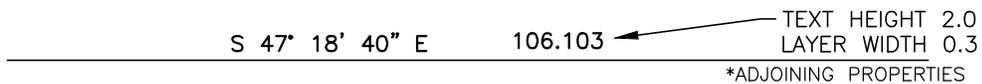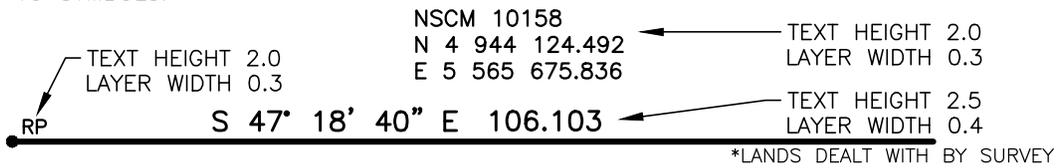

HATCH SURVEYED BUILDINGS USING:
 HATCH PATTERN — LINE
 LAYER WIDTH 0.2
 HATCH ANGLE 45° TO THE BUILDING LINE

HALIFAX

DRAWING STANDARDS

LINETYPES FOR LEGAL DRAWINGS

| | | |
|--------|-----------|--------------|
| DATE: | REFERENCE | APPROVED |
| 2021 | | |
| SCALE: | | FIG No.: |
| NTS | | DS 19 |

LEGEND

| | |
|---|-------------------------------------|
|  | SURVEYED BOUNDARY |
|  | FENCE |
|  | SURVEY MARKER |
|  | NOVA SCOTIA HIGH PRECISION MONUMENT |
| FD | FOUND |
|  | IRON BAR |
|  | IRON PIPE |
|  | NAIL |
|  | ROCK POST |
|  | CUT CROSS |
|  | DRILL HOLE |
|  | UTILITY POLE |
|  | GUY WIRE ANCHOR |
|  | TREE |
| PID | PARCEL IDENTIFICATION NUMBER |
| PC | POINT OF CURVATURE |
| PCC | POINT OF COMPOUND CURVATURE |
| PRC | POINT OF REVERSE CURVATURE |
| A | ARC |
| R | RADIUS |
| SQ M | SQUARE METRES |
| SQ FT | SQUARE FEET |
| D | DEED |
| P | PLAN |
| M | MEASURED |
| PR | PLAN REFERENCE |
| R-O-W | RIGHT OF WAY |
| WIT | WITNESS |
| C | CALCULATED |
| HRM | HALIFAX REGIONAL MUNICIPALITY |
| NSPI | NOVA SCOTIA POWER INCORPORATED |
| ROD | REGISTRY OF DEEDS |
| LRO | LAND REGISTRATION OFFICE |
| [] | LAND SURVEYOR IDENTIFICATION |
| NI | NO IDENTIFICATION |
| OHWM | ORDINARY HIGH WATER MARK |
| BK, PG | BOOK, PAGE |
| DOC NO | DOCUMENT NUMBER |

NOTES:

1. IF YOU ARE PUTTING A SURVEY SYMBOL WITH TEXT ON A PLAN THE TEXT SHOULD BE A TEXT HEIGHT 2, LAYER WIDTH 0.3. EX: IP, M, AC.
2. ANY SYMBOLS INSERTED ON A SURVEY DRAWING EX: MANHOLE, TREE, UTILITY POLE, SHOULD BE CONSISTENT WITH ENGINEERING DRAWINGS

HALIFAX

DRAWING STANDARDS

**LEGEND
FOR LEGAL DRAWINGS**

| | | | |
|--------|------|-----------|--------------------------|
| DATE: | 2021 | REFERENCE | APPROVED |
| SCALE: | NTS | | FIG No.: DS 20 |

EXAMPLES

SUBJECT LANDS

P.I.D. NO.'S

L=WIDTH 0.3 H=2.0

LOT OR PARCEL IDENTIFIER

L=WIDTH 0.8 H=5.0 (TEXT HEIGHT MAY VARY ACCORDING TO DRAWING SIZE BUT SHOULD MATCH THE TITLE BLOCK).

AREA 000 SQ.M.

L=WIDTH 0.3 H=2.0

PLAN REFERENCE

L=WIDTH 0.3 H=2.0

OWNER(S) NAME(S)

L=WIDTH 0.53 H=3.5

BOOK & PAGE REFERENCE

L=WIDTH 0.3 H=2.0

GHOSTED TEXT

L=WIDTH 0.2 H=4.5

PLAN REFERENCE
(USUALLY A SUBJECT LOT THAT IS BEING SUBDIVIDED)

L=WIDTH 0.3 H=2.0

ADJOINERS LAND

P.I.D. NO.'S

L=WIDTH 0.3 H=2.0

LOT OR PARCEL IDENTIFIER LOT OR PARCEL IDENTIFIER

L=WIDTH 0.53 H=3.0 } SIZE MAY VARY
L=WIDTH 0.53 H=3.5 } ACCORDING TO SPACE

PLAN REFERENCE

L=WIDTH 0.3 H=2.0

OWNER(S) NAME(S)

L=WIDTH 0.4 H=3.0

BOOK & PAGE REFERENCE

L=WIDTH 0.3 H=2.0

| |
|------------|
| L = LAYER |
| H = HEIGHT |

NOTES:

1. STREET NAMES SHOULD BE LARGE AND STAND OUT.
2. ALL TEXT SHOULD BE A MINIMUM HEIGHT OF 2.0.
3. CHANGES IN TEXT HEIGHT AND WEIGHT MAY VARY ACCORDING TO THE PROJECT.
4. WHEN SHOWING COORDINATES, AREAS, ETC IN METRIC DO NOT USE COMMAS. USE A SPACE TO SEPARATE BLOCKS OF 3 DIGITS. A SPACE IS OPTIONAL WITH A 4 DIGIT NUMBER.

| | | |
|---|-----------|----------|
| HALIFAX | | |
| DRAWING STANDARDS | | |
| LOT IDENTIFIERS & TEXT SIZES FOR LEGAL DRAWINGS | | |
| DATE: | REFERENCE | APPROVED |
| 2021 | | |
| SCALE: | | FIG No.: |
| NTS | | DS 21 |

PLAN LEGEND

| EXISTING | | PROPOSED |
|----------|---------------------------|----------|
| | SURVEY CONTROL POINT | |
| | WATERVALVE | |
| | FIRE HYDRANT | |
| | UTILITY POLE AND GUY WIRE | |
| | SIGN POST/BASE | |
| | FENCE | |
| | GUIDERAIL | |
| | RETAINING WALL | |
| | CONCRETE CURB | |
| | PROPERTY LINE | |
| | BASELINE | |
| | SEWER MANHOLES | |
| | CATCHBASIN | |
| | GAS MAIN | |
| | CONCRETE SURFACE | |
| | ASPHALT SURFACE | |
| | EDGE OF GRAVEL SURFACE | |
| | WATERMAIN | |
| | TREE | |
| | DETECTOR LOOP | |
| | PEDESTRIAN RAMP | |
| | BUS STOP AND/OR SHELTER | |
| | HEDGE | |

HALIFAX

DRAWING STANDARDS

**LEGEND FOR TYPICAL
PLAN & PROFILE**

| | | |
|--------|------|----------------|
| DATE: | 2021 | REFERENCE |
| SCALE: | NTS | APPROVED |
| | | FIG No.: DS 22 |

PLAN LEGEND

| EXISTING | | RECORD |
|----------|---------------------------|--------|
| | SURVEY CONTROL POINT | |
| | FIRE HYDRANT | |
| | UTILITY POLE AND GUY WIRE | |
| | SIGN POST/BASE | |
| | FENCE | |
| | GUIDERAIL | |
| | RETAINING WALL | |
| | CONCRETE CURB | |
| | PROPERTY LINE | |
| | BASELINE | |
| | SEWER MANHOLES | |
| | CATCHBASIN | |
| | GAS MAIN | |
| | CONCRETE SURFACE | |
| | ASPHALT SURFACE | |
| | EDGE OF GRAVEL SURFACE | |
| | WATERMAIN | |
| | TREE | |
| | DETECTOR LOOP | |
| | PEDESTRIAN RAMP | |
| | BUS STOP AND/OR SHELTER | |
| | HEDGE | |

HALIFAX

DRAWING STANDARDS

**LEGEND FOR TYPICAL
RECORD DRAWING**

| | | |
|--------|-----------|----------|
| DATE: | REFERENCE | APPROVED |
| 2021 | | |
| SCALE: | | FIG No.: |
| NTS | | DS 23 |

NOTES

1. PLAN VALUES ARE BASED ON THE NOVA SCOTIA COORDINATE REFERENCING SYSTEM.
2. ALL WORK IS TO BE DONE IN ACCORDANCE WITH HRM CONTRACT DOCUMENTS.
3. GRADES SHOWN ARE APPROXIMATE. FINISHED GRADE IS TO BE APPROVED IN THE FIELD BY THE ENGINEER.
4. UTILITY INFORMATION IS APPROXIMATE ONLY. CONTRACTOR IS RESPONSIBLE TO ARRANGE FOR ON SITE LOCATES WITH ALL UTILITIES PRIOR TO START OF WORK. CONTACT www.info-ex.com AND OTHERS AS REQUIRED.
5. CONTRACTOR TO OBTAIN ALL NECESSARY PERMITS REQUIRED TO PERFORM WORK AND TO COMPLY WITH ALL APPLICABLE ENVIRONMENTAL REGULATIONS.
6. WHERE EXISTING CONDITIONS ARE SHOWN THEY ARE NOT NECESSARILY ACCURATE OR COMPLETE. THE CONTRACTOR SHALL CONFIRM ALL EXISTING DIMENSIONS AND LOCATIONS AND REPORT ANY DISCREPANCIES TO THE ENGINEER.
7. THE CONTRACTOR SHALL CHECK AND VERIFY ALL PROPOSED DIMENSIONS BEFORE PROCEEDING WITH CONSTRUCTION. ANY ADJUSTMENTS WILL BE MADE BY THE ENGINEER AS NECESSARY.
8. CONTRACTOR IS RESPONSIBLE FOR SETTING GRADES AND LAYOUT CONTROL.
9. TRAFFIC SIGNS ARE NOT TO BE REMOVED OR REPLACED WITHOUT AUTHORIZATION FROM THE TRAFFIC AUTHORITY AND THE ENGINEER.
10. THE CONTRACTOR IS RESPONSIBLE FOR PROTECTION OF TREES. TREES ARE NOT TO BE REMOVED WITHOUT PERMISSION FROM THE ENGINEER.
11. WORK IN THE IMMEDIATE AREA OF A NOVA SCOTIA COORDINATE MONUMENT MUST BE CARRIED OUT BY HAND. THE CONTRACTOR IS RESPONSIBLE FOR ANY COSTS IF MONUMENTS ARE DISTURBED.
12. AT COMPLETION OF WORK REINSTATE ALL DISTURBED SURFACES TO THE SATISFACTION OF THE ENGINEER.
13. WATER VALVE BOX EXTENSIONS – THE MINIMUM INSIDE DIAMETER OF A VALVE BOX EXTENSION SHALL BE 125 mm AND THE MINIMUM LENGTH OF A VALVE BOX EXTENSION SHALL BE 300 mm. CONTRACTOR TO CONFIRM APPROPRIATE PRODUCT TO BE USED WITH HALIFAX WATER OPERATIONS DEPARTMENT STAFF.
14. ALL PROPOSED PEDESTRIAN RAMPS TO INCLUDE TACTILE WALKING SURFACE INDICATOR PLATES AS PER HRM DETAIL 131 UNLESS OTHERWISE NOTED.

HALIFAX

DRAWING STANDARDS

**NOTES FOR
TYPICAL PLAN & PROFILE**

| | | | |
|--------|------|-----------|--------------------------|
| DATE: | 2021 | REFERENCE | APPROVED |
| SCALE: | NTS | | FIG No.: DS 24 |

