


Appendix D

CERTIFICATE OF INSTALLATION
On-site sewage system as built construction details

Site plan must include drawing of lot layout illustrating the location of the system installed, direction of and % slope, location of structures (proposed or existing), watercourse(s), well(s) and other confining features identified in the standard including required clearance distances, in relation to the system location.

may include separate attachment for site plan

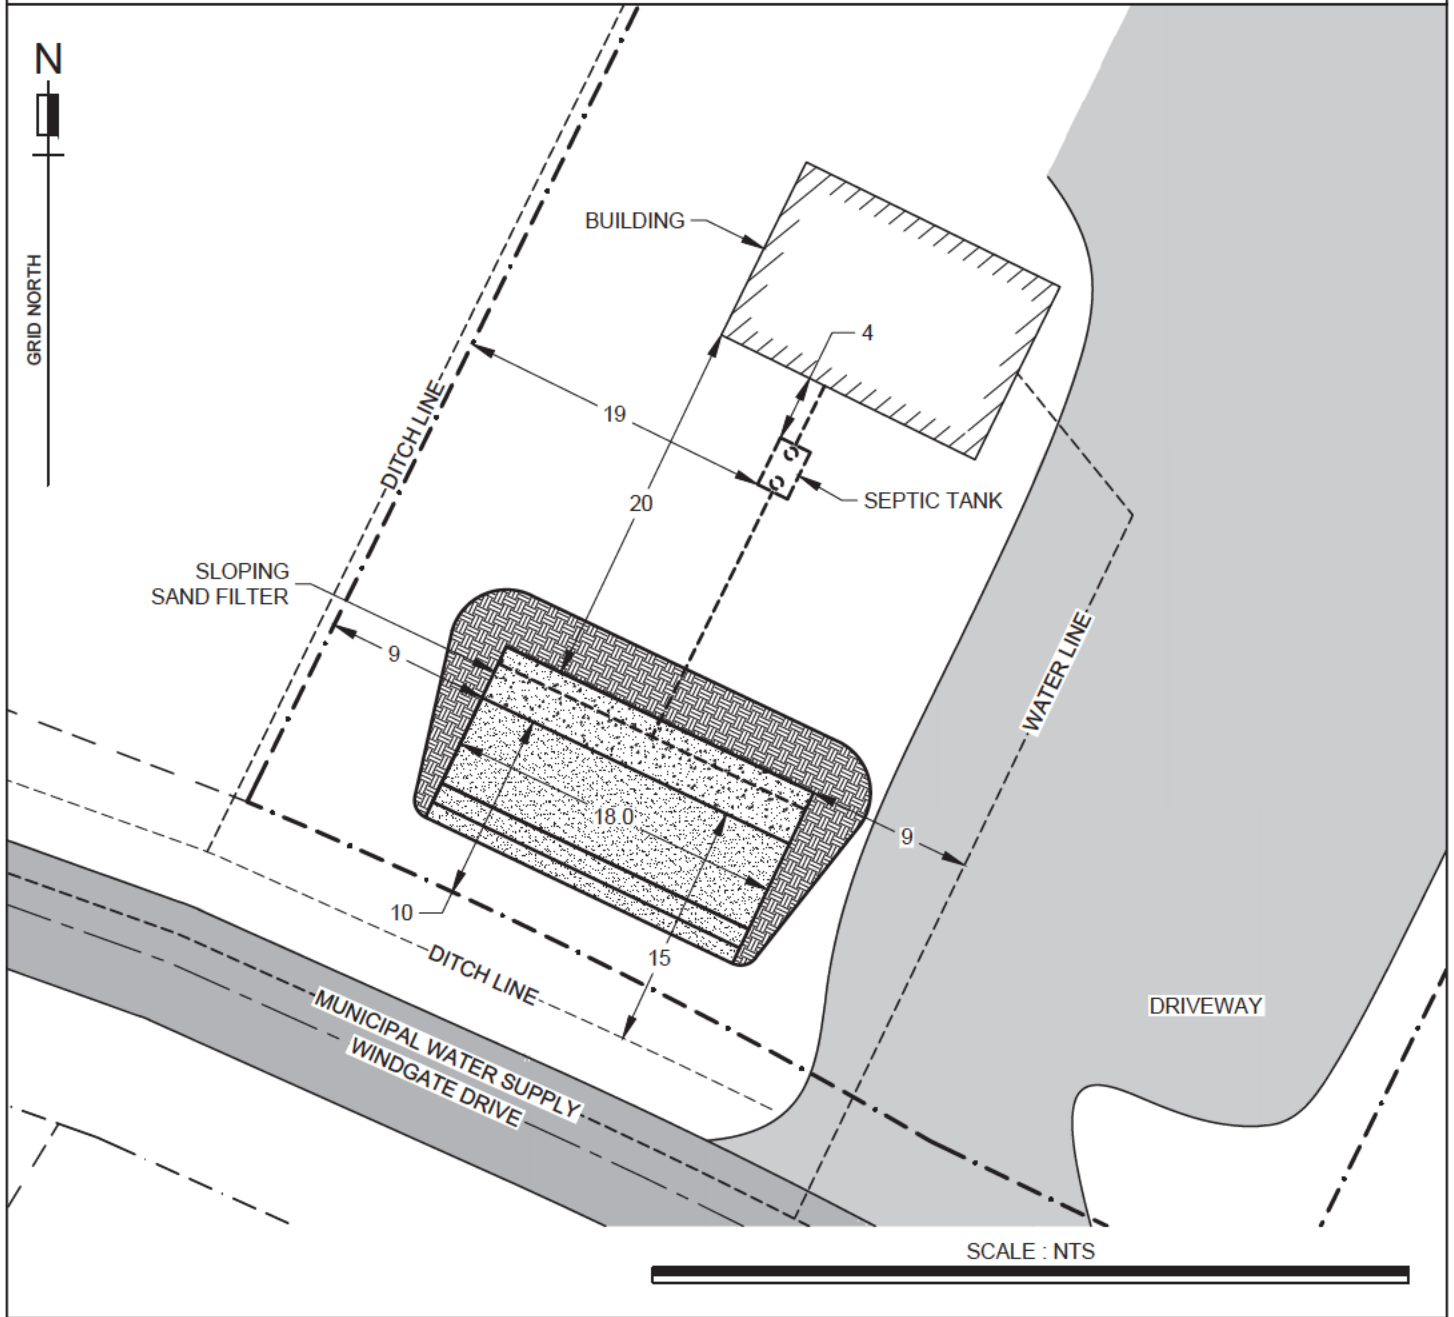

DATE: 07NOV2023

Professional engineer or qualified person:

QP or P. Eng. #: 8176

A. Veinotte

A. VEINOTTE
(Print name)